


T. IS. R. 32E. W.M.

G-6361
49211

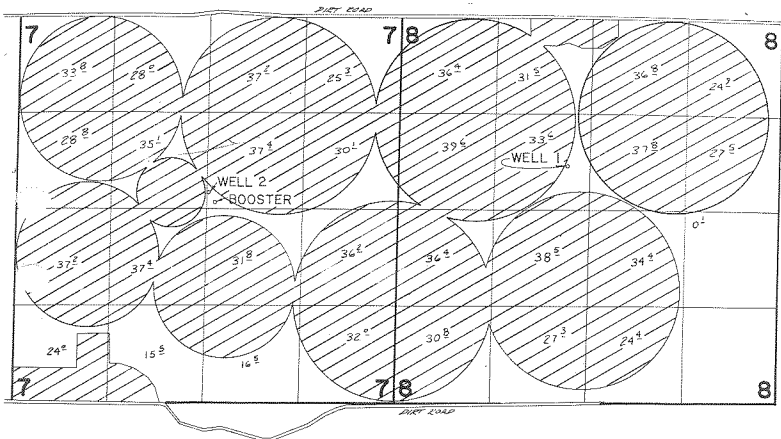

WELL 1 LOC. 600'N & 300'W FROM CENTER COR. SEC 8
WELL 2 LOC. 230'N & 30'E FROM CENTER COR. SEC 7

FINAL PROOF SURVEY UNDER

APPL. G-7101 PER. G-6361
IN NAME OF

RONALD R. REESER

SURVEYED 2-15-79 BY R. BARWIN