


T. 1 S. R. 3 W. W.M.

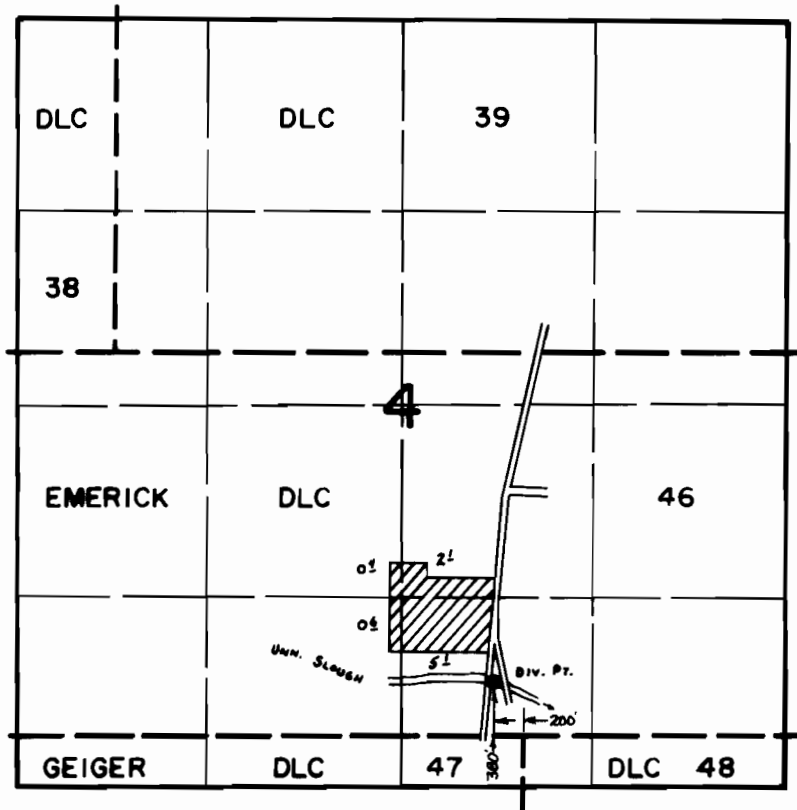

FINAL PROOF SURVEY
UNDER

Application No. 34111... Permit No. 26886.....
IN NAME OF

LLOYD WIEDEWITSCH

Surveyed Mar. 26, 19.63, by M. BISH