


T. 7S. R. 38E. W.M.

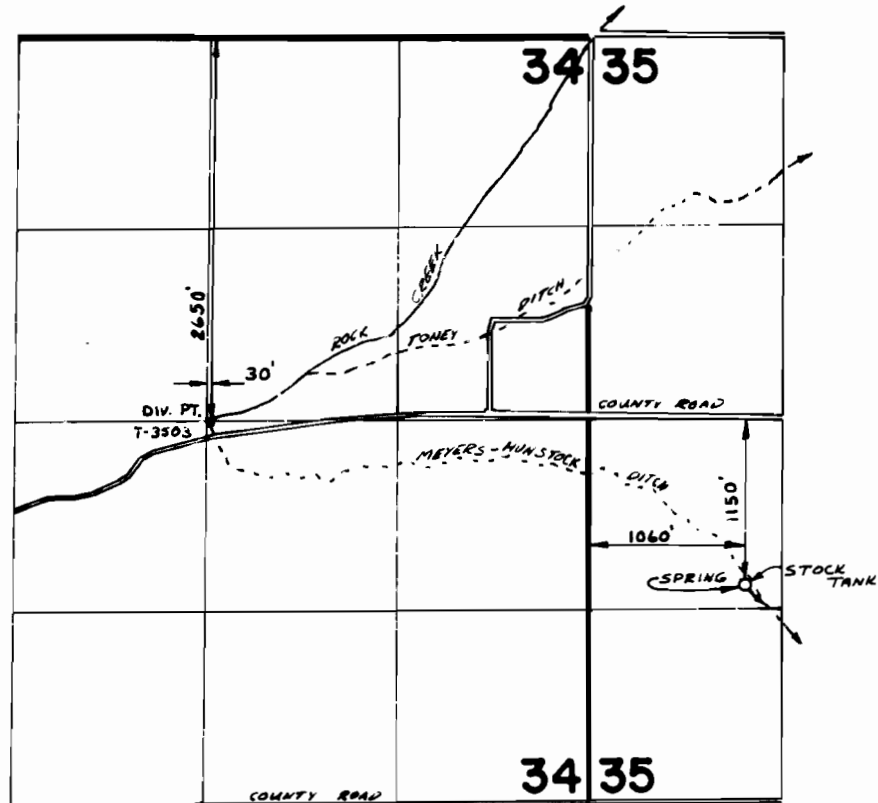

FINAL PROOF SURVEY
UNDER

TRANSFER 3503

Application No. 55234. Permit No. 42715.
IN NAME OF

.....**FRANCIS B. ZIMMERMAN**.....

Surveyed 8-28 1979., by V. Chusak & P. Jewett