


T. 7S. R. 38E. W.M.

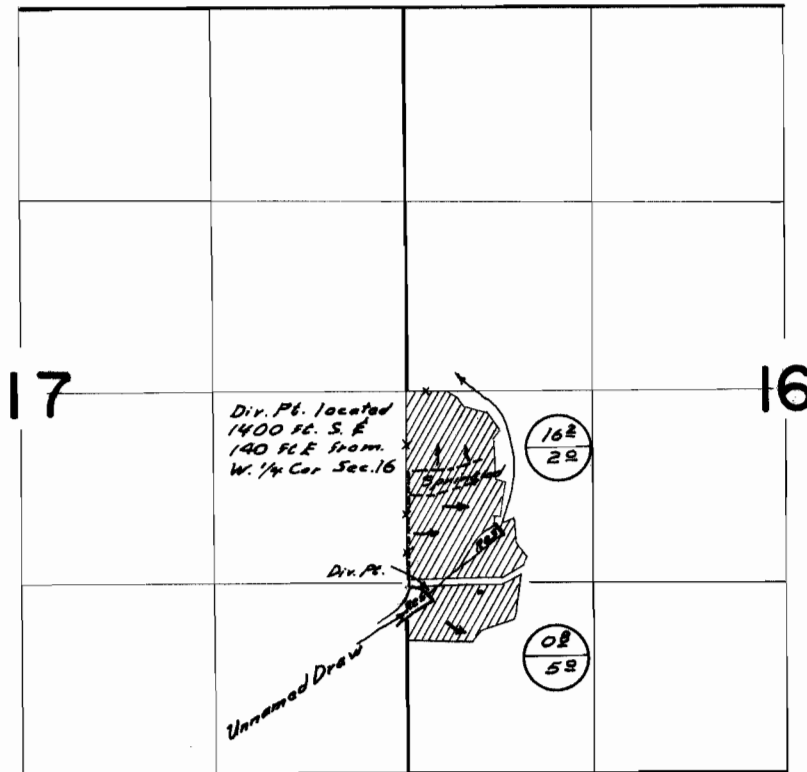

FINAL PROOF SURVEY
UNDER

Application No. 37537 Permit No. 28494
IN NAME OF

Lester J. & Marie K. Robbs

Surveyed Aug 5 1966, by H. J. Suggart