


# T.12S., R.4W., W.M.

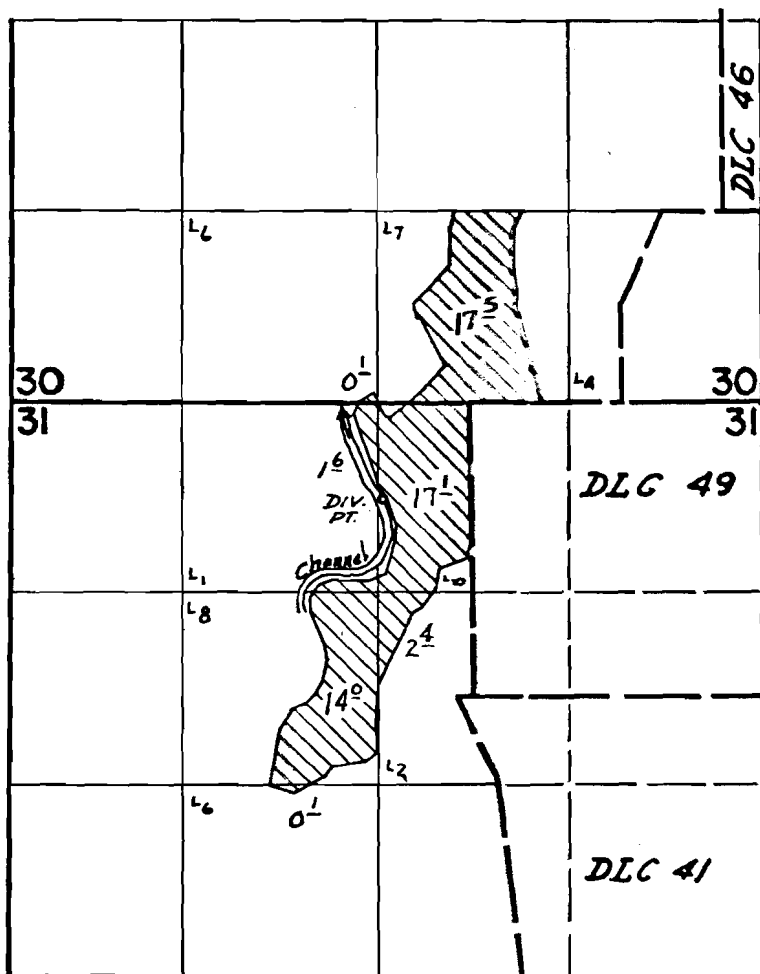

2ND PT. LOC.: 3290'S & 40' E FROM CENTER SEC. 30.

## FINAL PROOF SURVEY UNDER

Application No. 47756 Permit No. 35771  
IN NAME OF

ROY HATHAWAY

Surveyed April 22, 1975, by D. Norby