T.10&11S. R.3W., W.M.

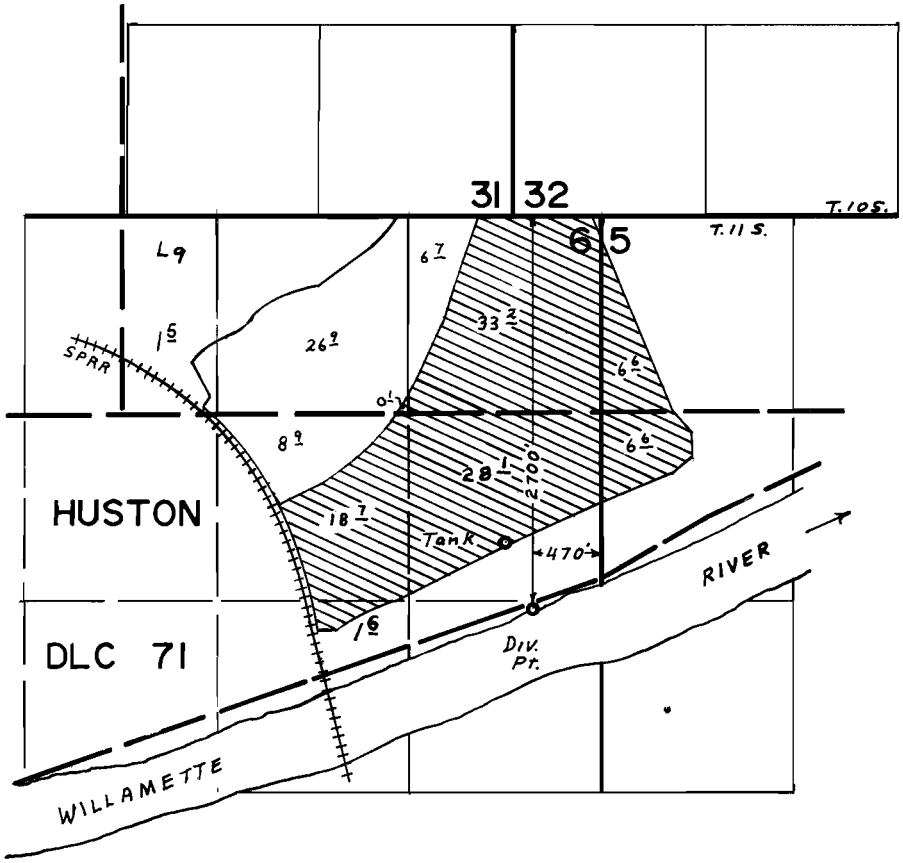

FINAL PROOF SURVEY
UNDER

Application No. 50191 Permit No. 37884
IN NAME OF

STOKELY-VAN CAMP, INC.

Surveyed OCT. 3 1978, by S.P. APPLEGATE

DFM-ZLL-19 29