


T.29S. R.14&15W. W.M.

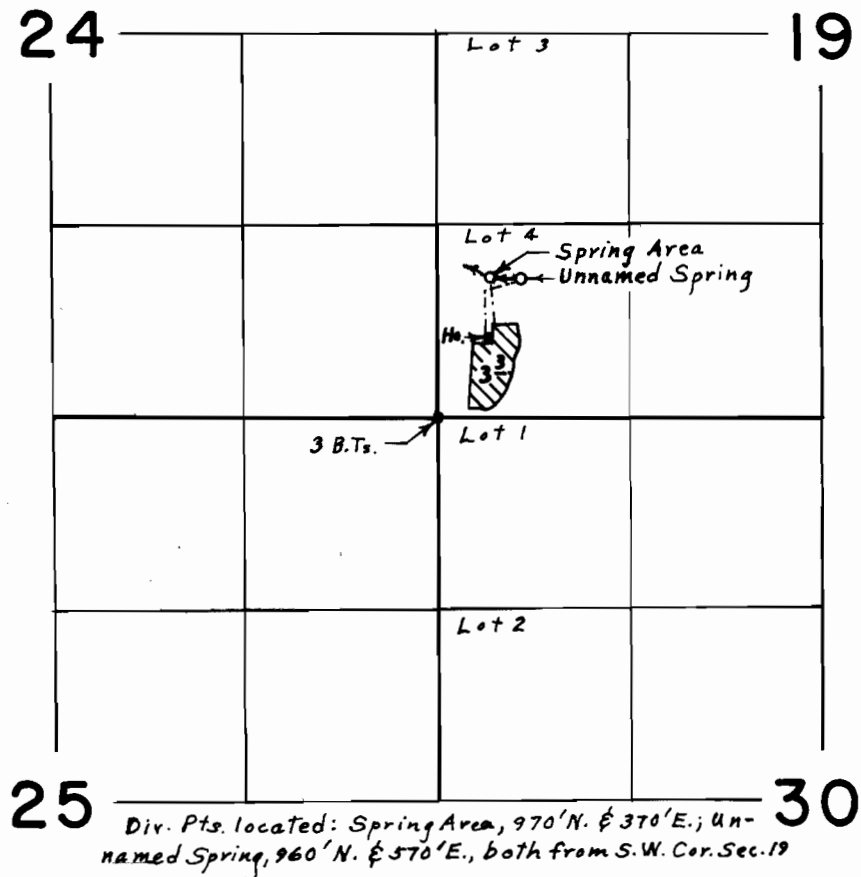

FINAL PROOF SURVEY
UNDER

Application No. 47464. Permit No. 35230.
IN NAME OF

Michael P. Keller

Surveyed Aug. 28., 1976, by L. E. Gould