


T.27S. R.3W. W.M.

Sec. 12

SCALE: 1" = 400'

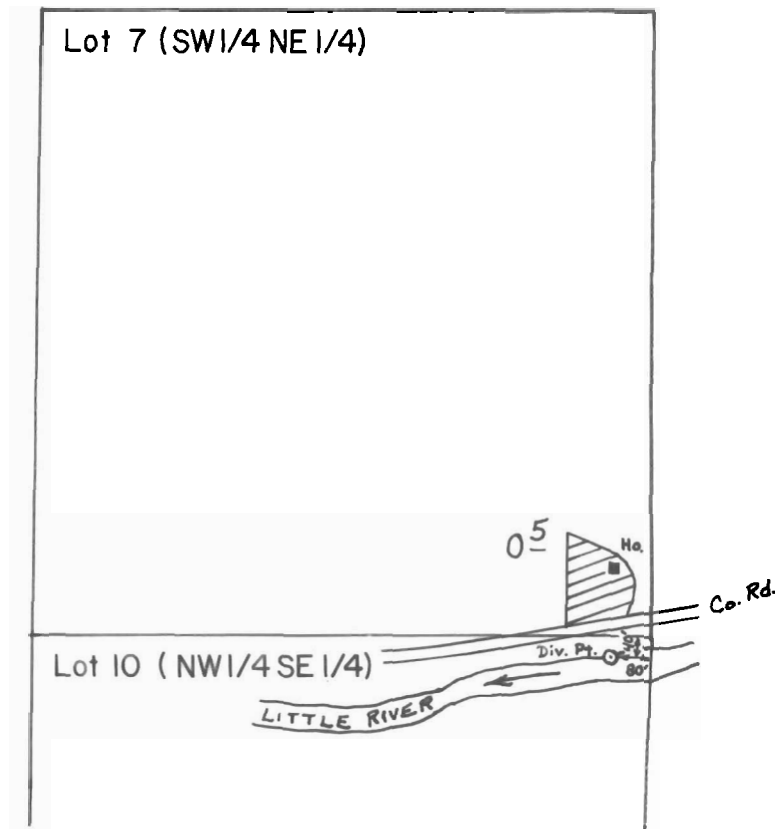

**FINAL PROOF SURVEY**  
UNDER

Application No. 49548 Permit No. 37086  
IN NAME OF

RALPH E. & FLORA H. SHEARN

Surveyed May 9, 1978, by D. Sparks