


T. 27 S., R. 5 W., W.M.

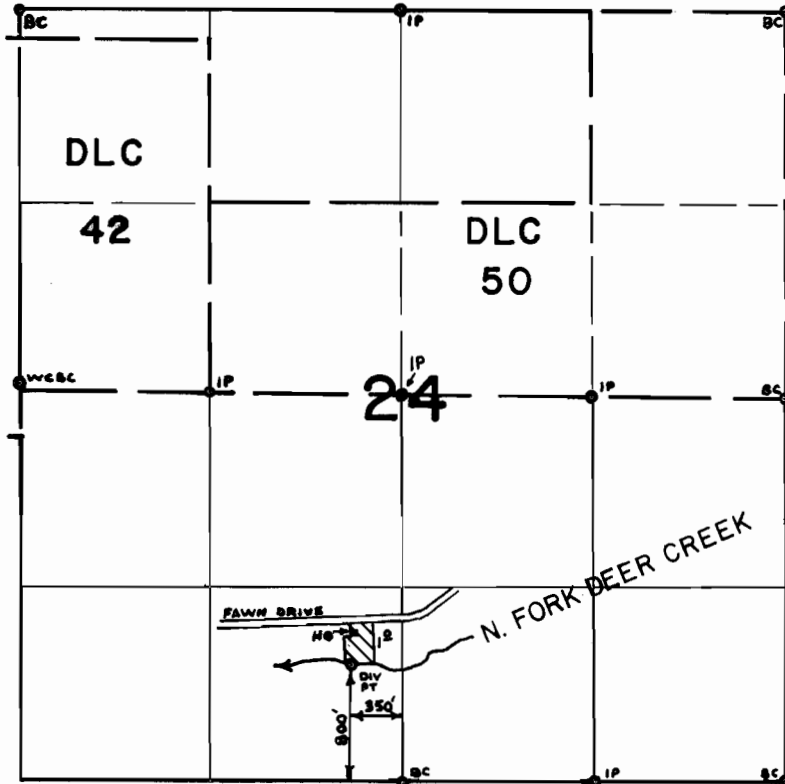

FINAL PROOF SURVEY
UNDER

Application No. 51886... Permit No. 39053.
IN NAME OF

EUGENE TERRELL FAIRCLOTH

Surveyed OCT. 21. 1977, by D.W. SPARKS.