


T.27S. R.2 $\frac{1}{2}$ 3W. W.M.

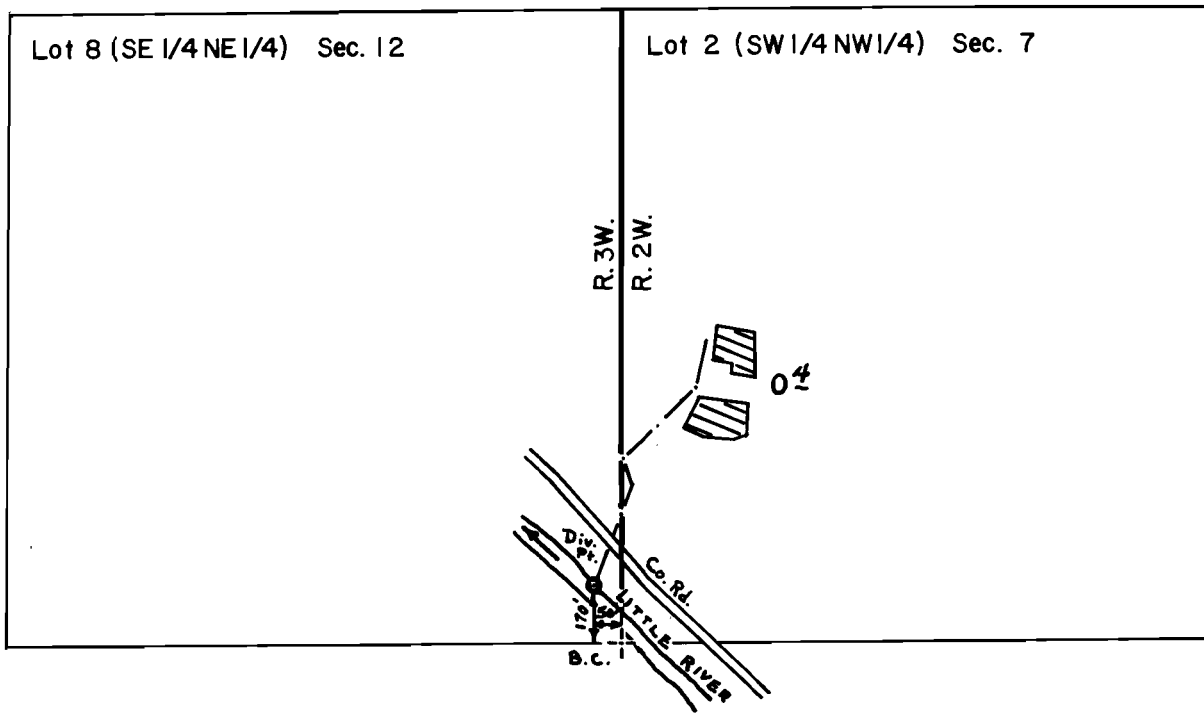

SCALE: 1" = 400'

**FINAL PROOF SURVEY**  
UNDER

Application No. 50004 Permit No. 37603

IN NAME OF

WENDALL HANCOCK

Surveyed MAY 9 1978, by D. SPARKS