


T.27S. R.3W. W.M.

Sec. 2

SE 1/4 NW 1/4

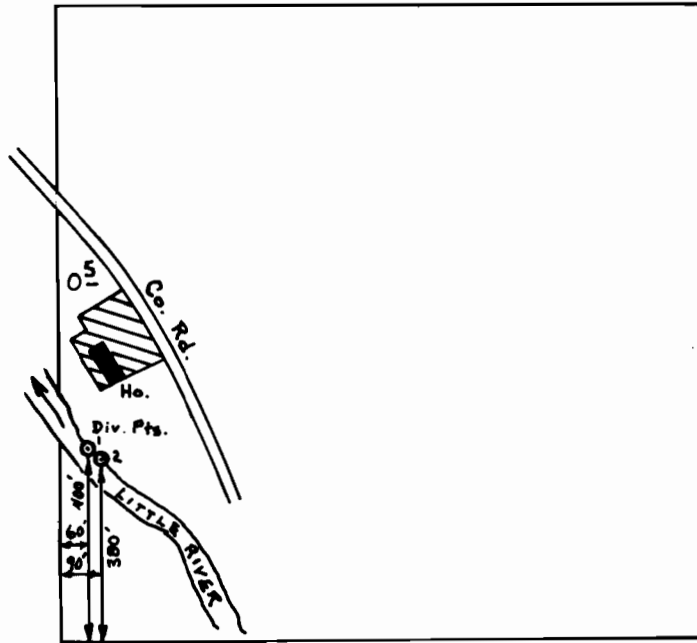

SCALE: 1" = 400'

**FINAL PROOF SURVEY**  
UNDER

Application No. 54000 Permit No. 40410  
IN NAME OF

ROY. A. HANSEN

Surveyed June 13, 1978., by D. Sparks.....