


T.25S., R.6W., W.M.

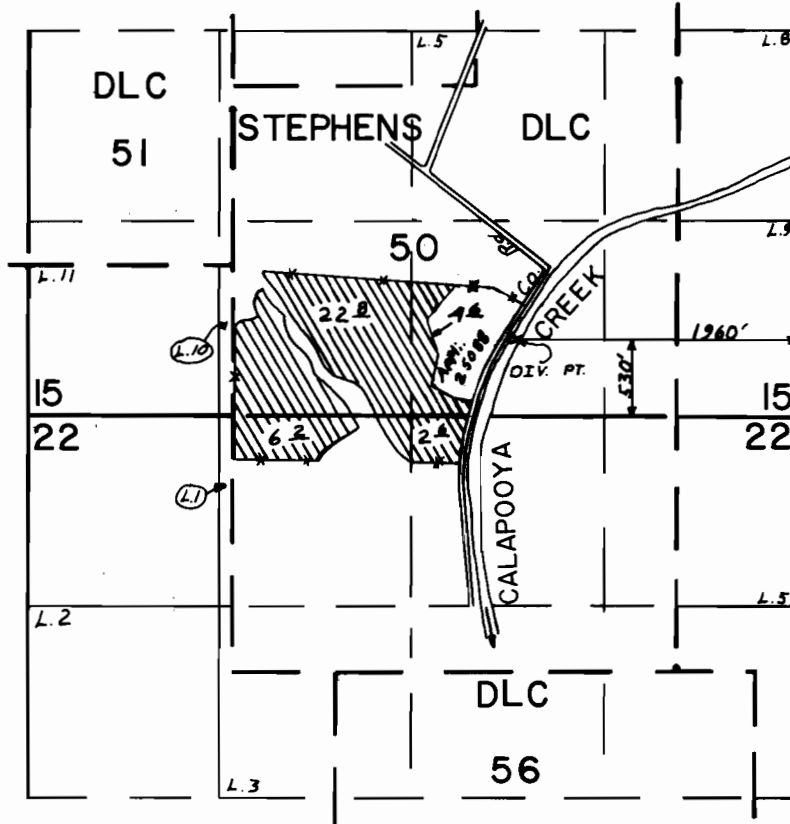

FINAL PROOF SURVEY UNDER

Application No. 50222 Permit No. 37704
IN NAME OF

PAUL T. & KARLEN J. MUELLER

Surveyed OCT. 20. 1977., by D.W. SPARKS.