


# T.35 S., R.3 W., W.M.

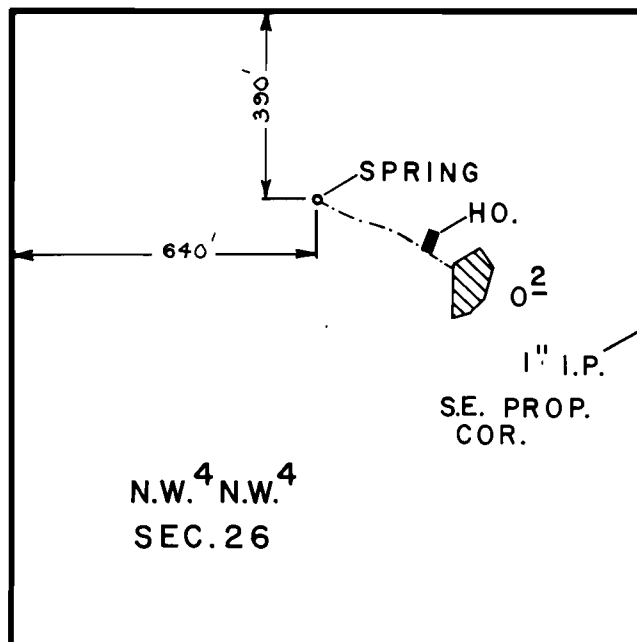

SCALE: 1" = 400 FT.

## FINAL PROOF SURVEY UNDER

Application No. 40861 Permit No. 30460  
IN NAME OF

WALTER D. FITZGERALD

Surveyed APR. 30 1979, by B. SUND

D.H.M.  
P.T.S. - 1979 - 14 - A