


T. 35 S., R. 4 W., W.M.

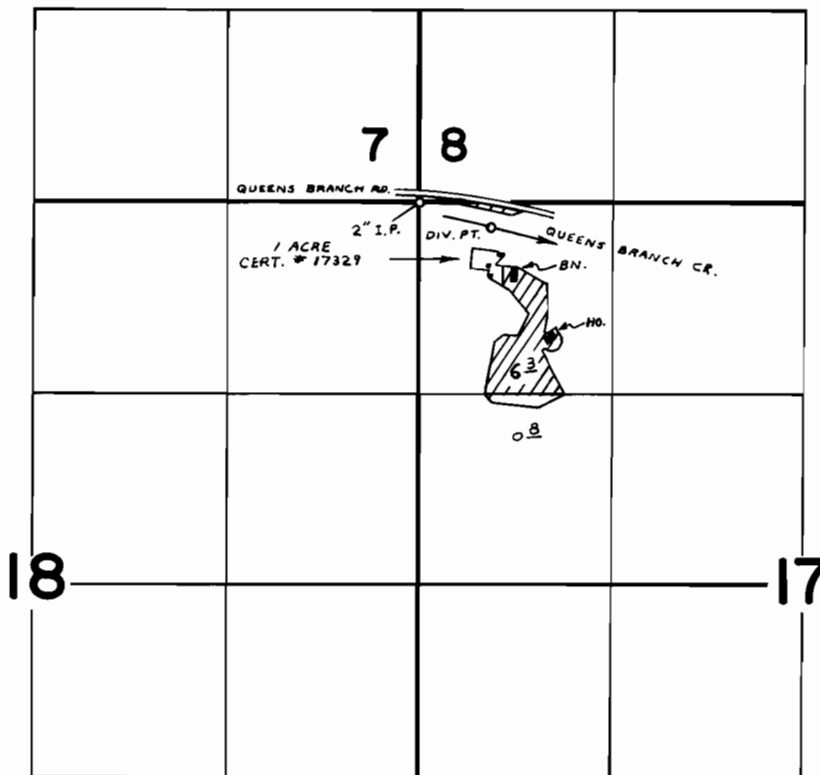

DIV. PT. LOC.: 180' S. & 490' E. FROM NW COR. SEC. 17

**FINAL PROOF SURVEY
UNDER**

Application No. 43144 Permit No. 32230
IN NAME OF

EUGENE L. MARS

Surveyed DEC. 9 1977, by B. SUND