


T.37&38S.,R.4W.,W.M.

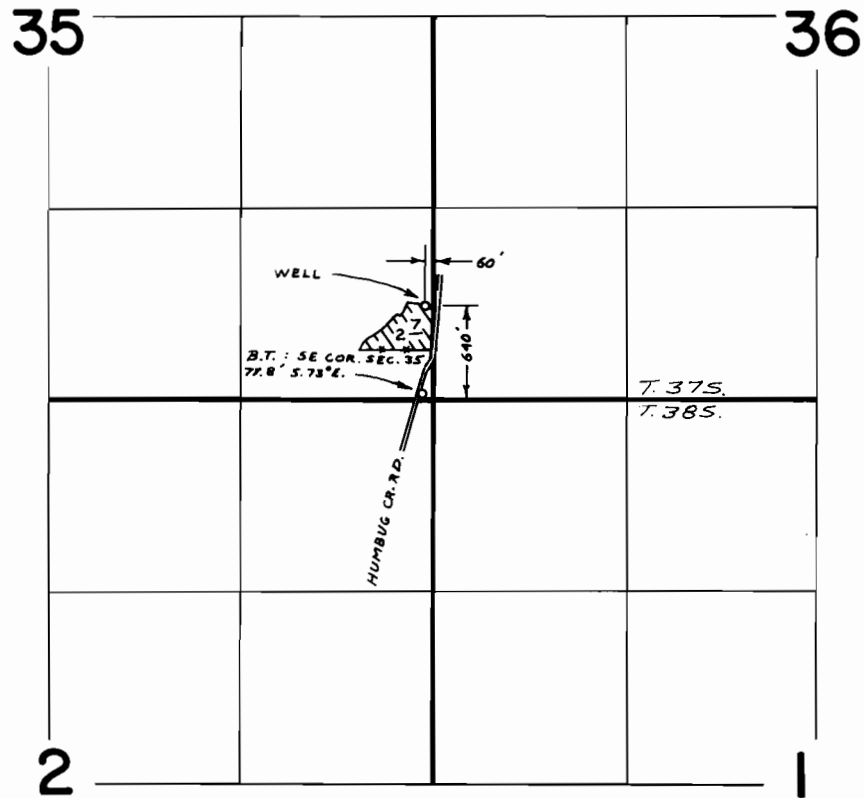

FINAL PROOF SURVEY
UNDER

Application No. G-6946 Permit No. G-6461
IN NAME OF

DENNIS F. SIGMON

Surveyed JUL. 10 1978, by B. SUND