


T.3S. R.6W. W. M.

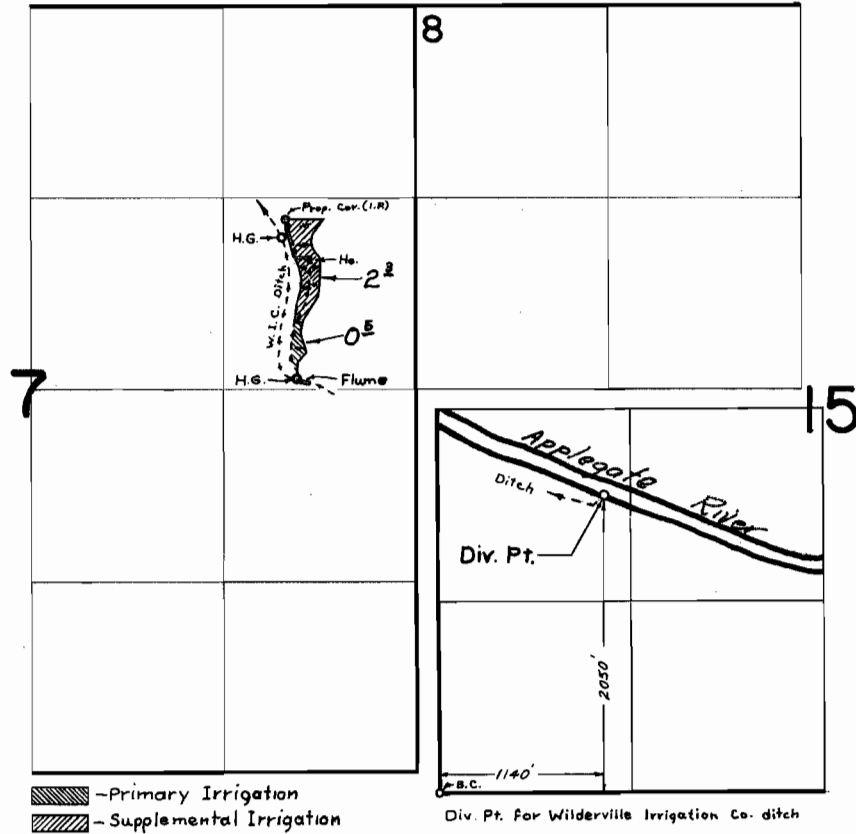

**FINAL PROOF SURVEY**  
UNDER

Application No. 41730 Permit No. 31156  
IN NAME OF

M. Craig Lowry

Surveyed MAY 21, 1974, by L.E. GOULD