


T.37S., R.6W., W.M.

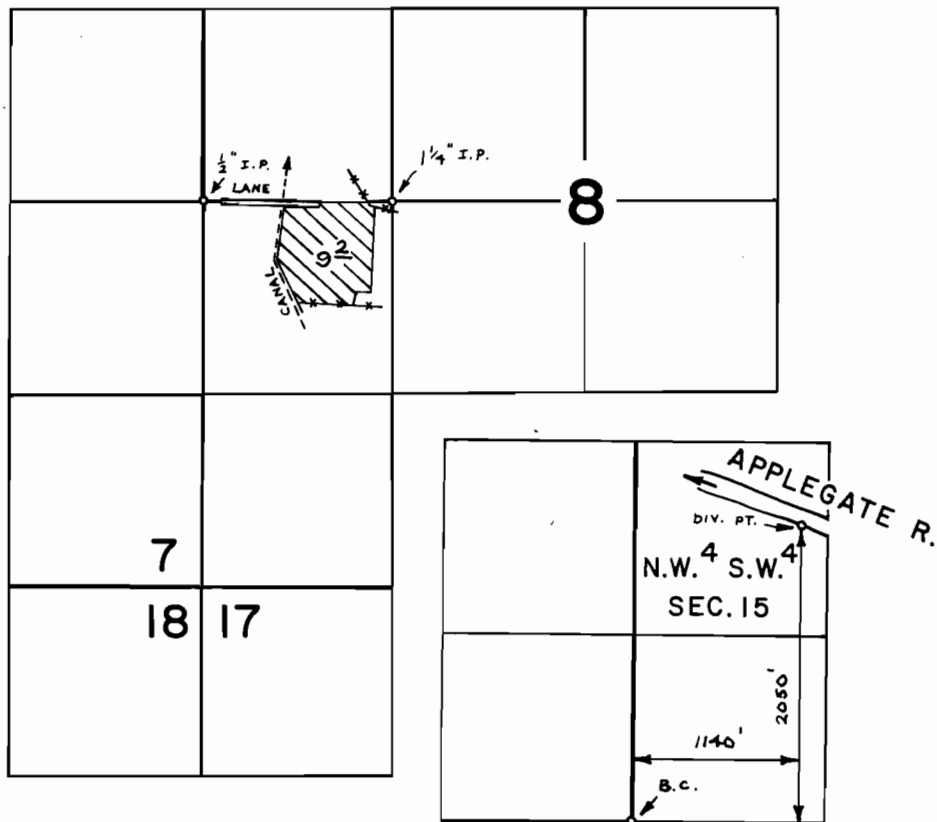

**FINAL PROOF SURVEY**  
UNDER

Application No. 53095 Permit No. 38582

IN NAME OF

JAMES L. ROBINSON

Surveyed OCT. 12 1977 by B. SUND