


T.35 S., R.6 W., W.M.

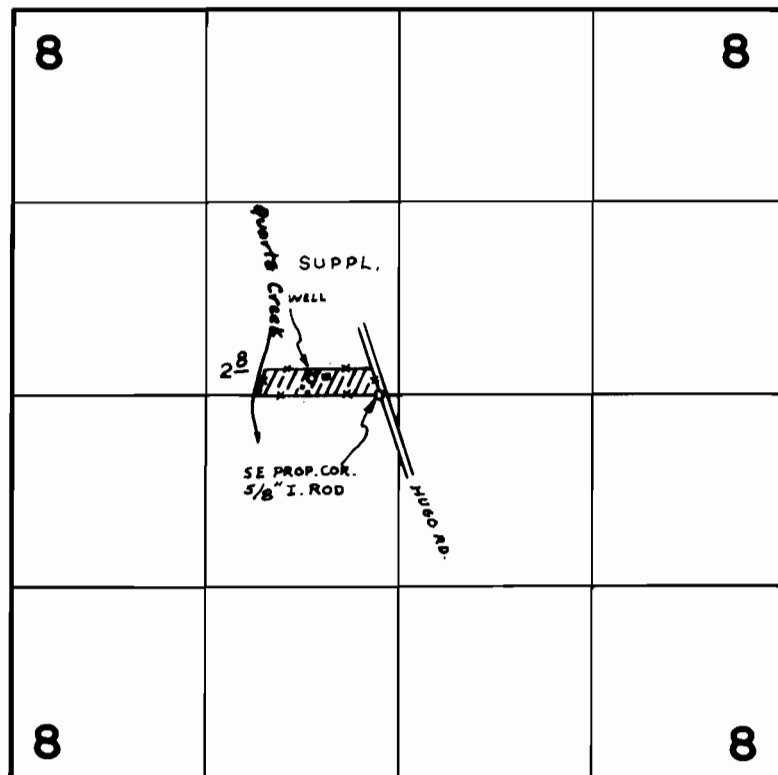

WELL LOC. : 110' N. & 600' W. FROM C'4 COR. SEC. 8

FINAL PROOF SURVEY
UNDER

Application No. G-5978 Permit No. G-5664
IN NAME OF

FRED & BERNICE H. SARGENT

Surveyed NOV. 16 1977, by B. SUND