


T.36S.R.1E.W.M.

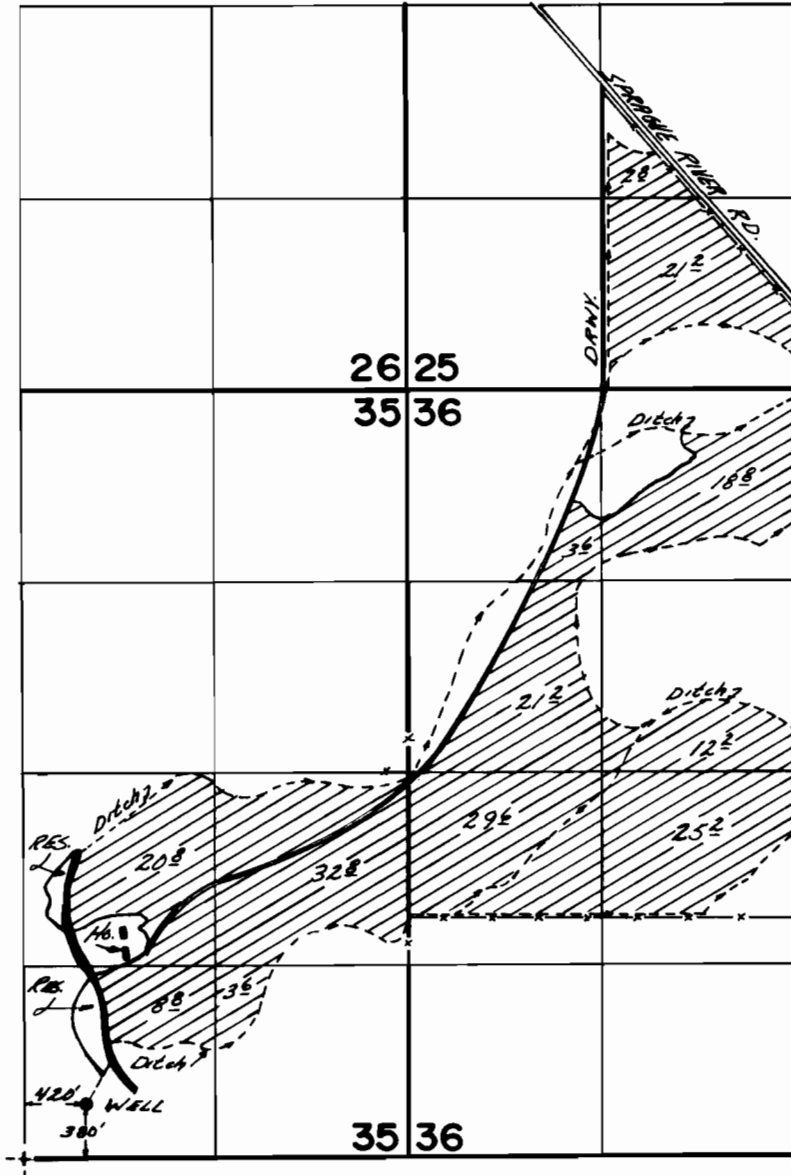

FINAL PROOF SURVEY UNDER

Application No. G-5564 Permit No. G-5810
IN NAME OF

.....WILLIAM V. HILL.....

Surveyed Sept. 21 1979, by C.R.RODRIGUEZ