


T. 36S. R. 12E. WM.

5

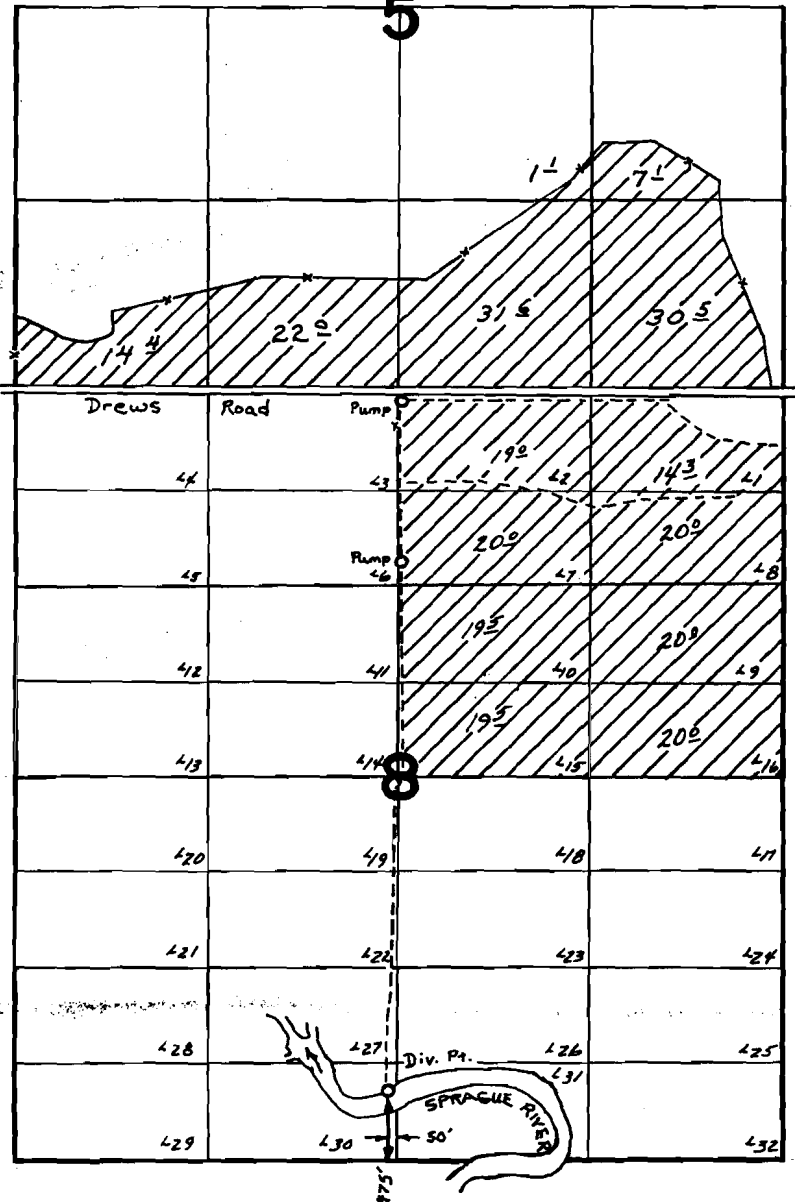

Sprague River

FINAL PROOF SURVEY UNDER

Application No. 44235. Permit No. 32737. IN NAME OF

PAUL H. FAIRCLO

Surveyed AUG. 23, 1977, by D. NQRBY