


**T. 20S. R. 3W. W.M.**

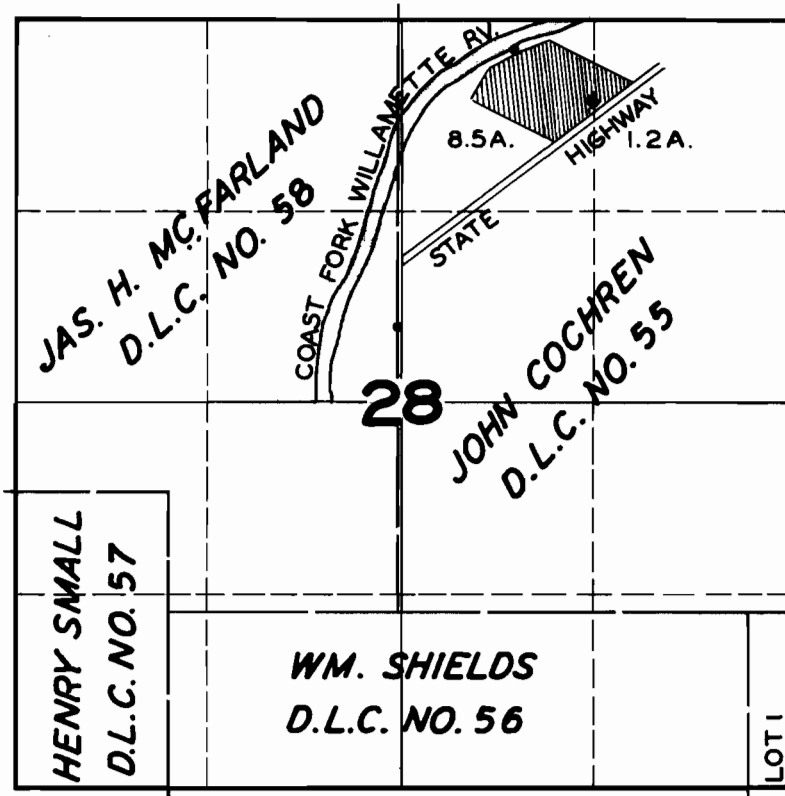

**FINAL PROOF SURVEY**  
UNDER

Application No. **20713**..... Permit No. **16195**.....  
IN NAME OF

**MARGARET HECK**

Surveyed **JULY 20 1948**, by **JAS. E. BUNNELL**