


T.18S.R.1W.W.M.

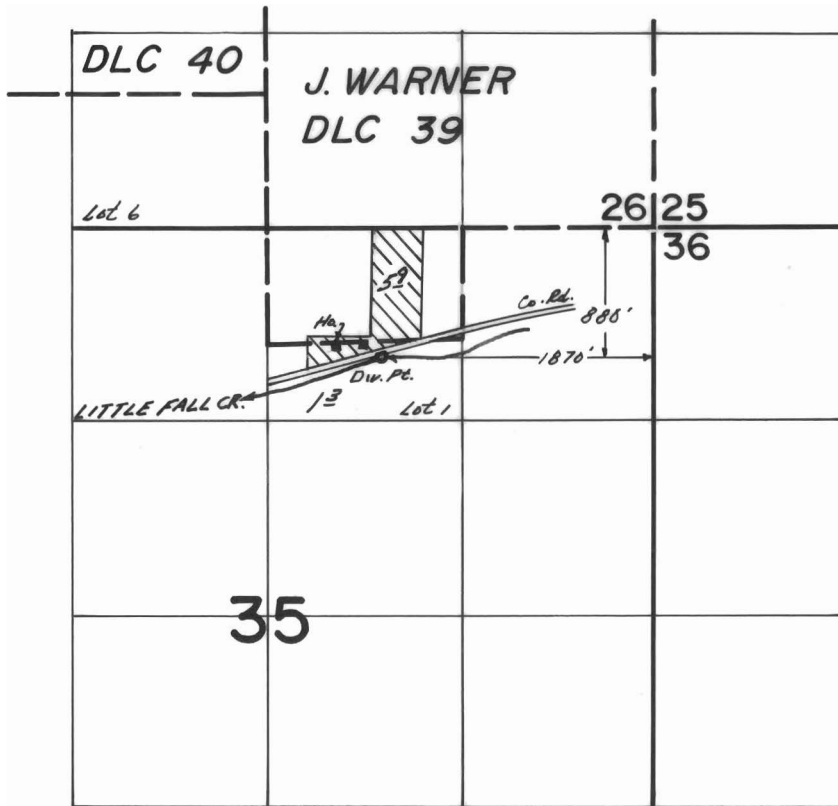

FINAL PROOF SURVEY

UNDER

Application No. 55214.. Permit No. 4141.....
IN NAME OF

J. DAVID DUNCAN

Surveyed June 29 1979, by S.C.BROWN.....

CRK