


T.19S. R.12W., W.M.

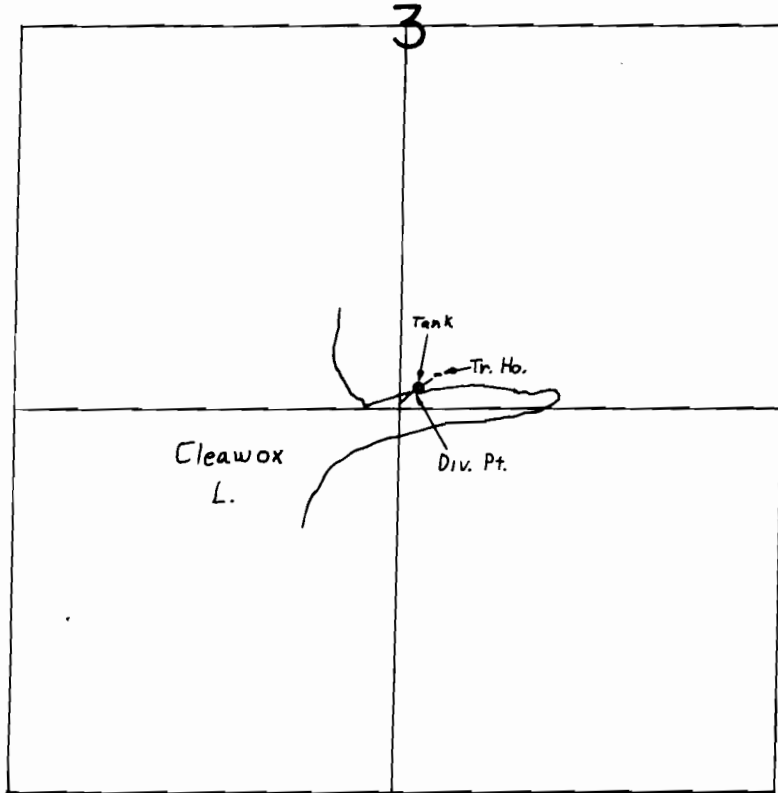

Div. Pt. Loc. 1260' S. & 40' E. From Center Sec. 3

Scale : 1" = 660'

FINAL PROOF SURVEY
UNDER

Application No. 52657. Permit No. 39681....
IN NAME OF

.....
Surveyed AUG. 24 19.77, by B.R. SUND.....