


# T17S. R2W. WM.

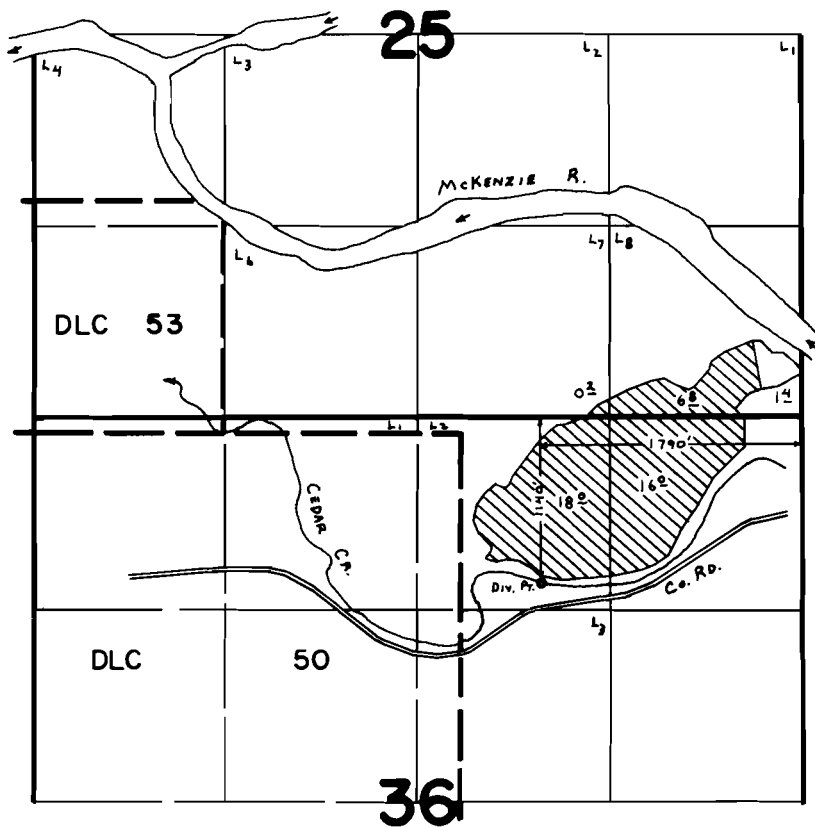

## FINAL PROOF SURVEY UNDER

Application No. 55758. Permit No. 43075.....  
IN NAME OF

WILDISH LAND CO.

Surveyed June 21, 1979, by C. L. HUGHES.....