


# T. 7S. R. 2W. W.M.

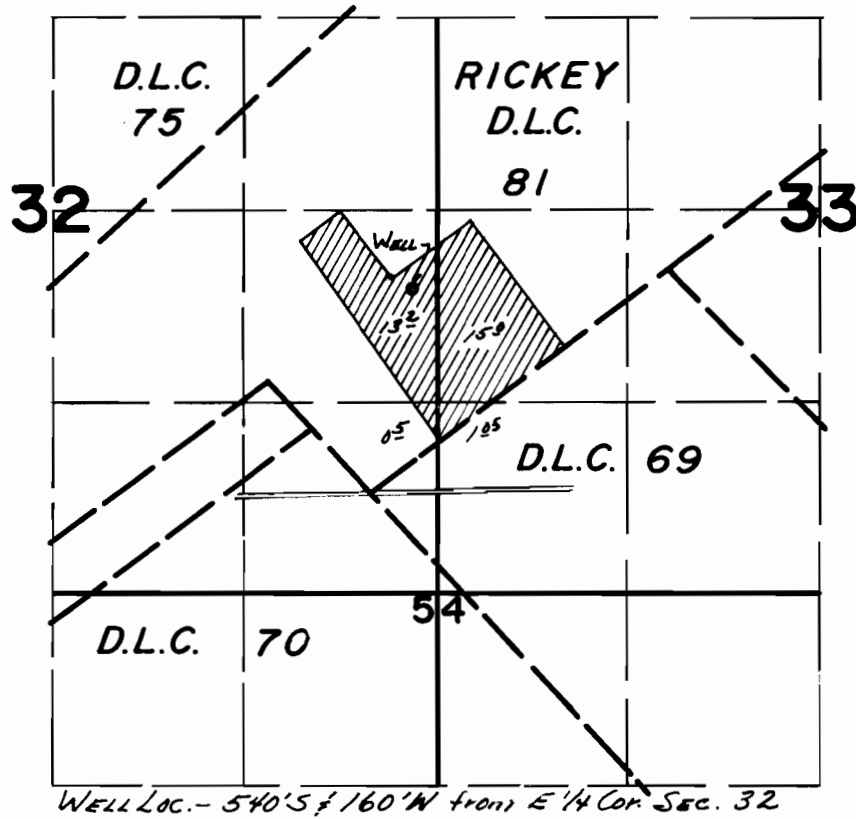

## FINAL PROOF SURVEY UNDER

Application No. G-7574 Permit No. G-7033.  
IN NAME OF

PHILLIP A. GINTHER,

Surveyed April 27 1978, by R.G. Mucken...