


T.7S. R.1W., W.M.

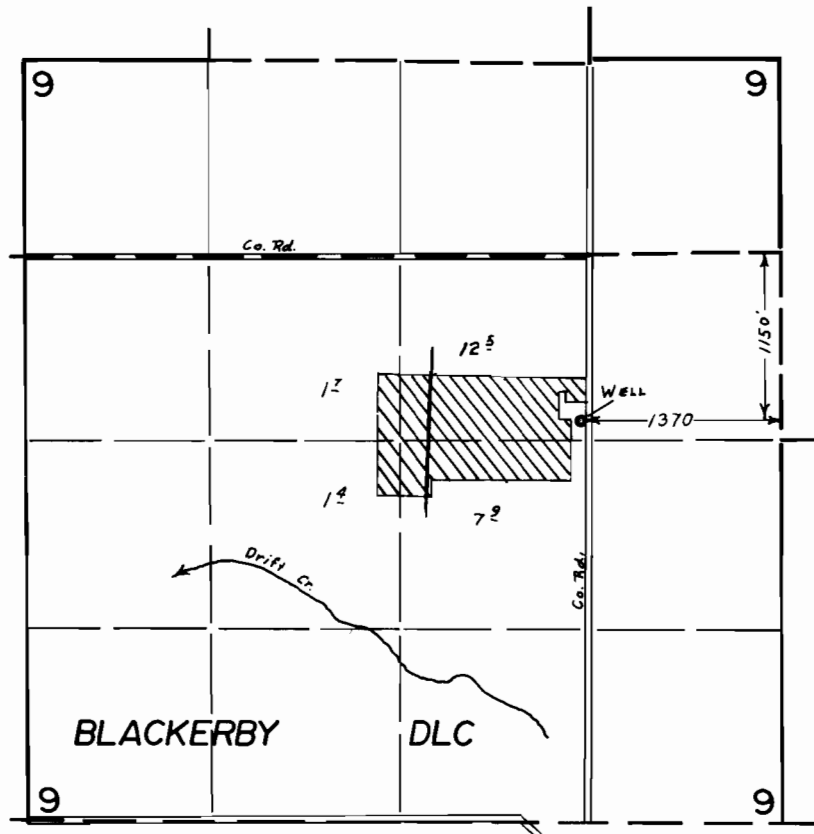

FINAL PROOF SURVEY
UNDER

Application No. G-6432. Permit No. G-6039.....
IN NAME OF

.....DENZEL J. BROWN.....

Surveyed MAY 31 1979, by L. H. NUNN.....