


T. 5S. R. 2W. W. M.

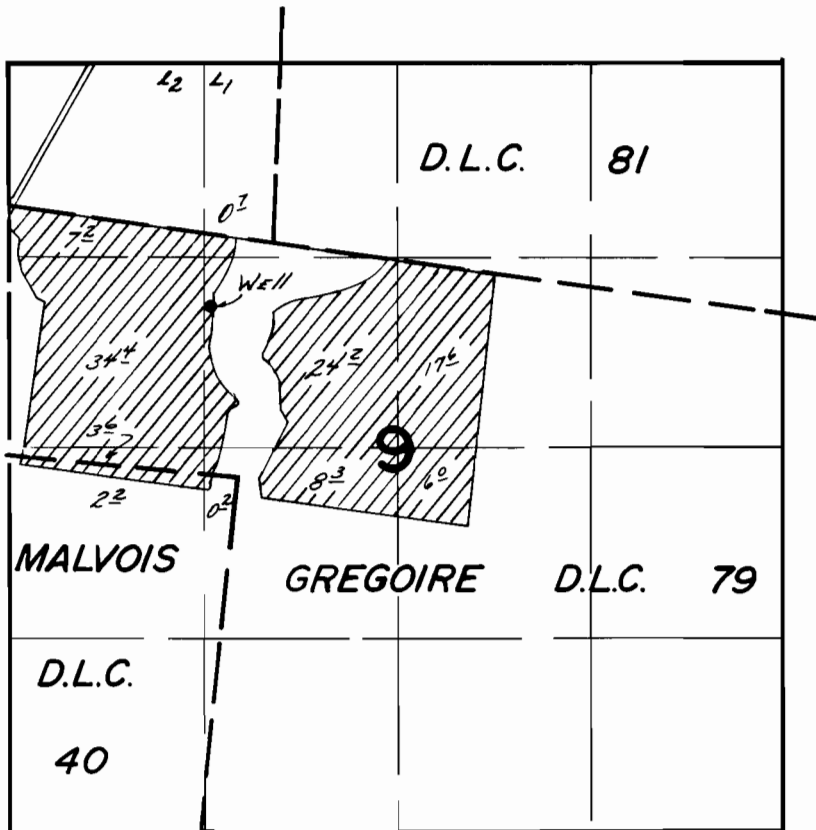

Well Loc. - 1670' S & 1380' E from NW Cor. Sec. 9

FINAL PROOF SURVEY UNDER

Application No. G-7045 Permit No. G-6532
IN NAME OF

JOHN NIBLER

Surveyed June 7, 1979, by L.H. NUNN