-PLAT-

OF POINT OF DIVERSION
FOR WATER [illegible]LING OF [illegible] E. & M.A.
SPAULDING, ON UNNAMED CREEK IN
SW¼ SW¼ SEC. 26 T3 N. R. 10 E W.M.
HOOD RIVER COUNTY, OREGON.
Scale 2"=1 mile

OFFICE OF STATE ENGINEER
RECEIVED
MAR 26 1917
SALEM, OREGON

Application No. 5455
Permit No. 3317

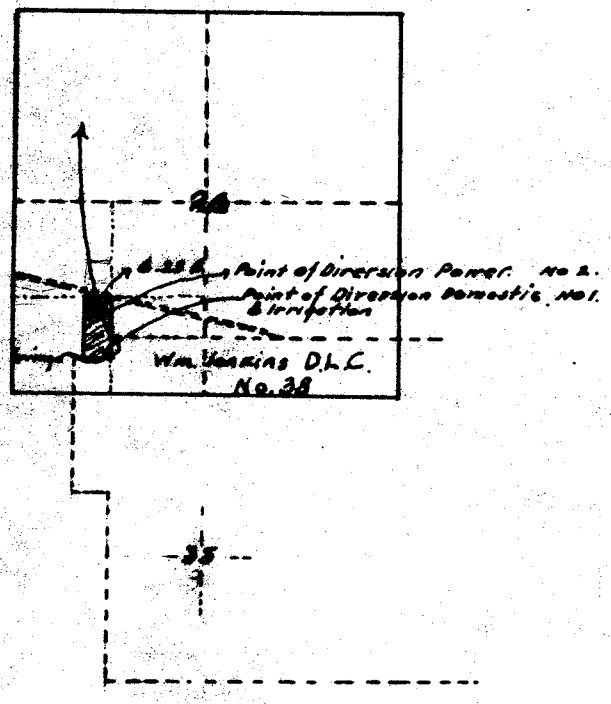

-CERTIFICATE-

I. L.A. Henderson, of Hood River, Oregon, do hereby certify that this map was made from an actual survey made by me Mch 14-1917, and correctly represents the works described in the accompanying application, together with location of springs and other ditches in the immediate vicinity, and has written thereon the area in each smallest legal subdivision which it is proposed to irrigate.

Dated Mch 17-1917

L.A. Henderson
Surveyor.

-LEGEND-

Point of Diversion No 1 is located on small creek flowing from unnamed Spring.
Point of Diversion No 2. is located on same.
No 1 is 8.00 chs R. and 30" [illegible] N.W. corner of Most Westerly Angle of Wm. Jenkins
D.L.C. No 38 in Sec 26 T 3 N. R. [illegible] W.M.
No 2 is 4.36 chs R. and 30 [illegible] same Corner.
Both points are on the Land [illegible] Applicant viz. 6.25 G. in S.W.¼ of S.W.¼