


T. 6N. R. 35E. W.M.

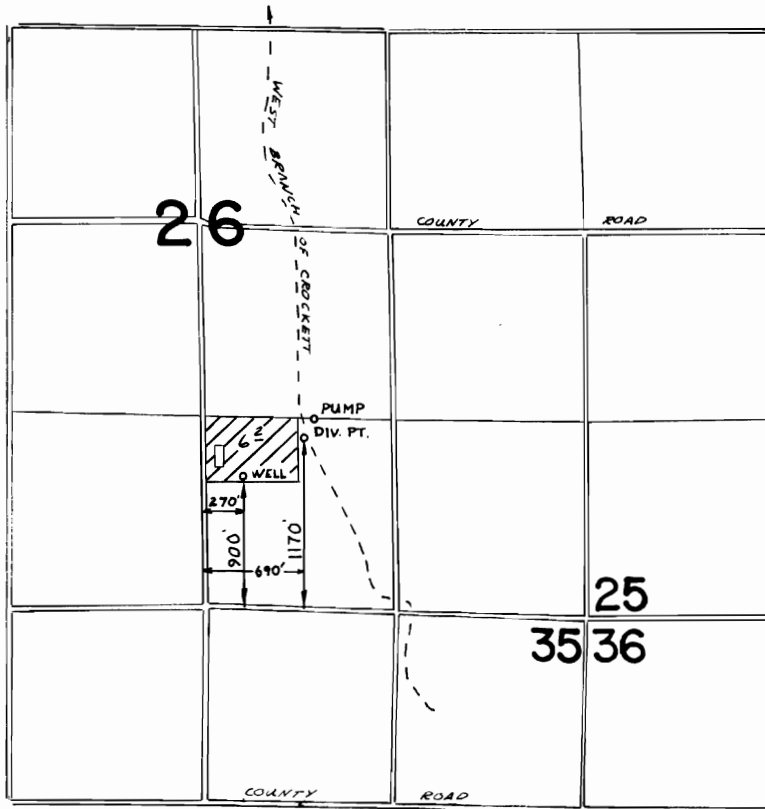

**FINAL PROOF SURVEY**  
UNDER

**TRANSFER 3638**

Application No. G-6502 Permit No. G-6666  
IN NAME OF

DON LeFORE

Surveyed 6-26 1979, by V. CHURCH