


# T. IS. R. 3W. W.M.

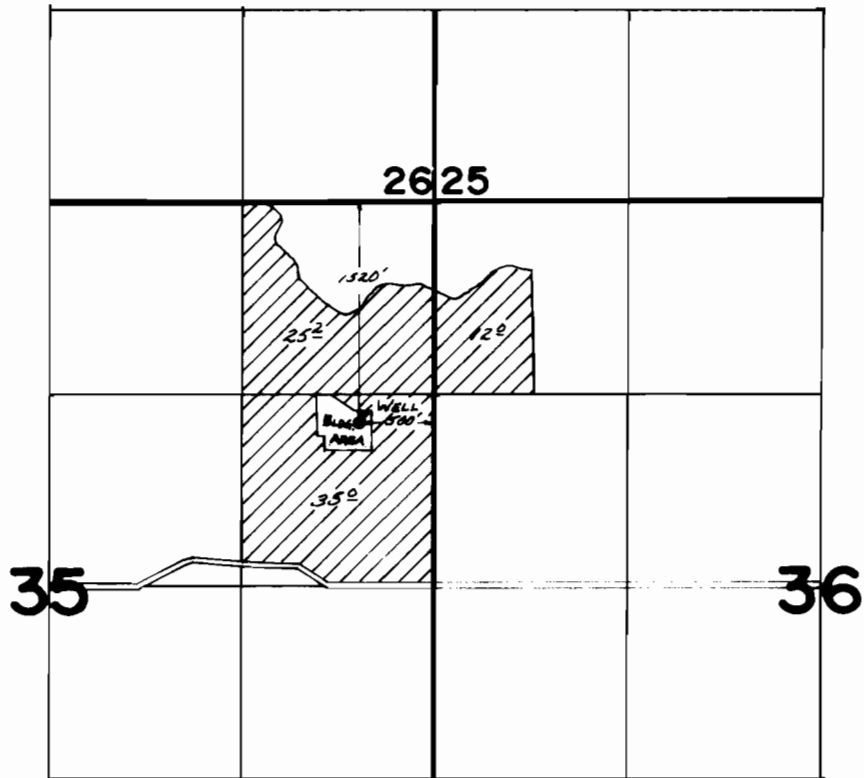

## FINAL PROOF SURVEY UNDER

Application No. G-6005 Permit No. G-5673  
IN NAME OF

.....ELDON G. BOGE.....

Surveyed May 3, 1977, by D.M. Norby.....