


T. 5 S., R. 6 W., W.M.

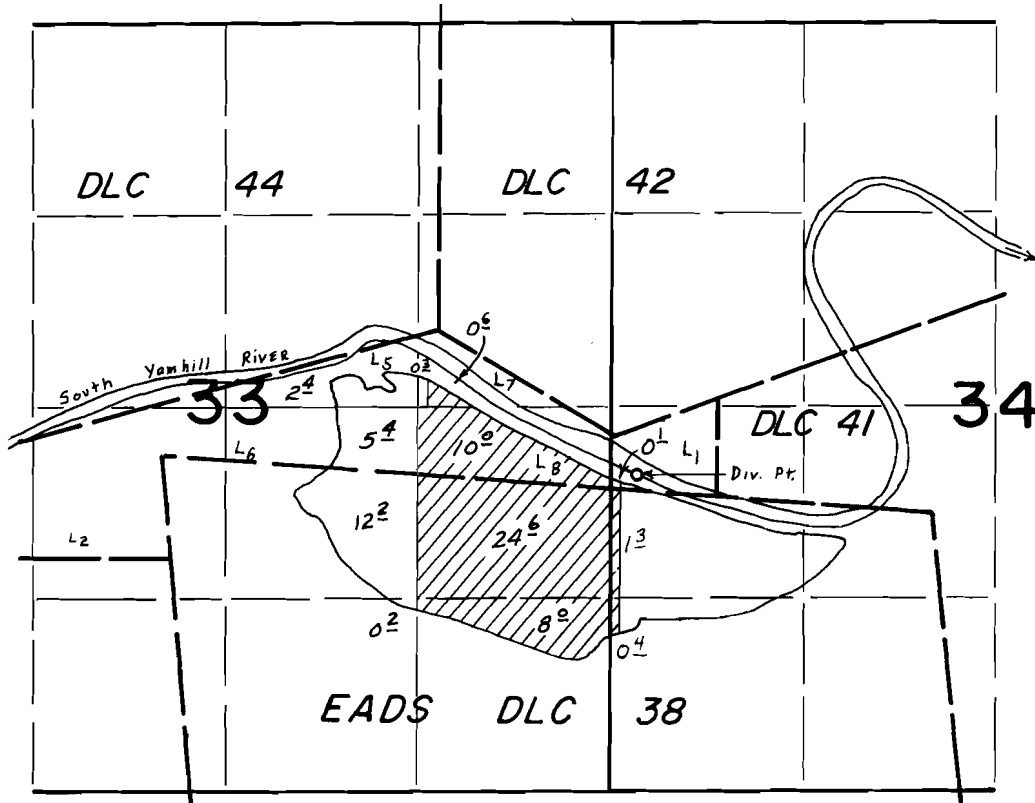

Div. Pt. Loc. 270' N. & 2020' W. From N.E. Cor. DLC 38

FINAL PROOF SURVEY
UNDER

Application No. 50812... Permit No. 38366.
IN NAME OF

.....W. H. BRANDT.....

Surveyed JULY 7... 1976, by L.H. NUNN.....