


T.9S. R.27E.W.M.

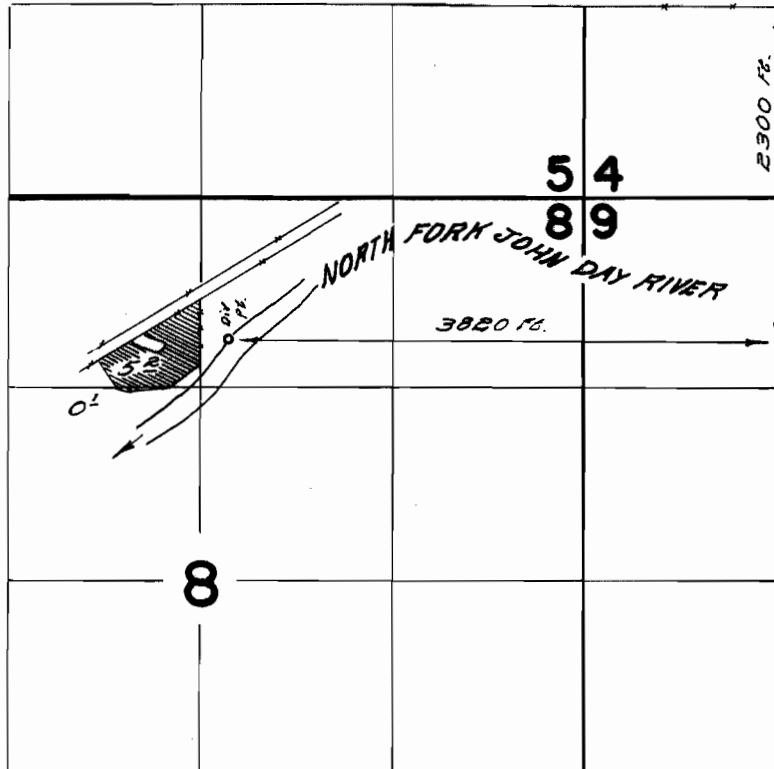

**FINAL PROOF SURVEY**  
UNDER

Application No. 39228 Permit No. 29229  
IN NAME OF

BEN M. SPAIN

Surveyed May 14, 1968, by W. J. Ruppert