


T13S R17E Sec 5 NW14 NW14

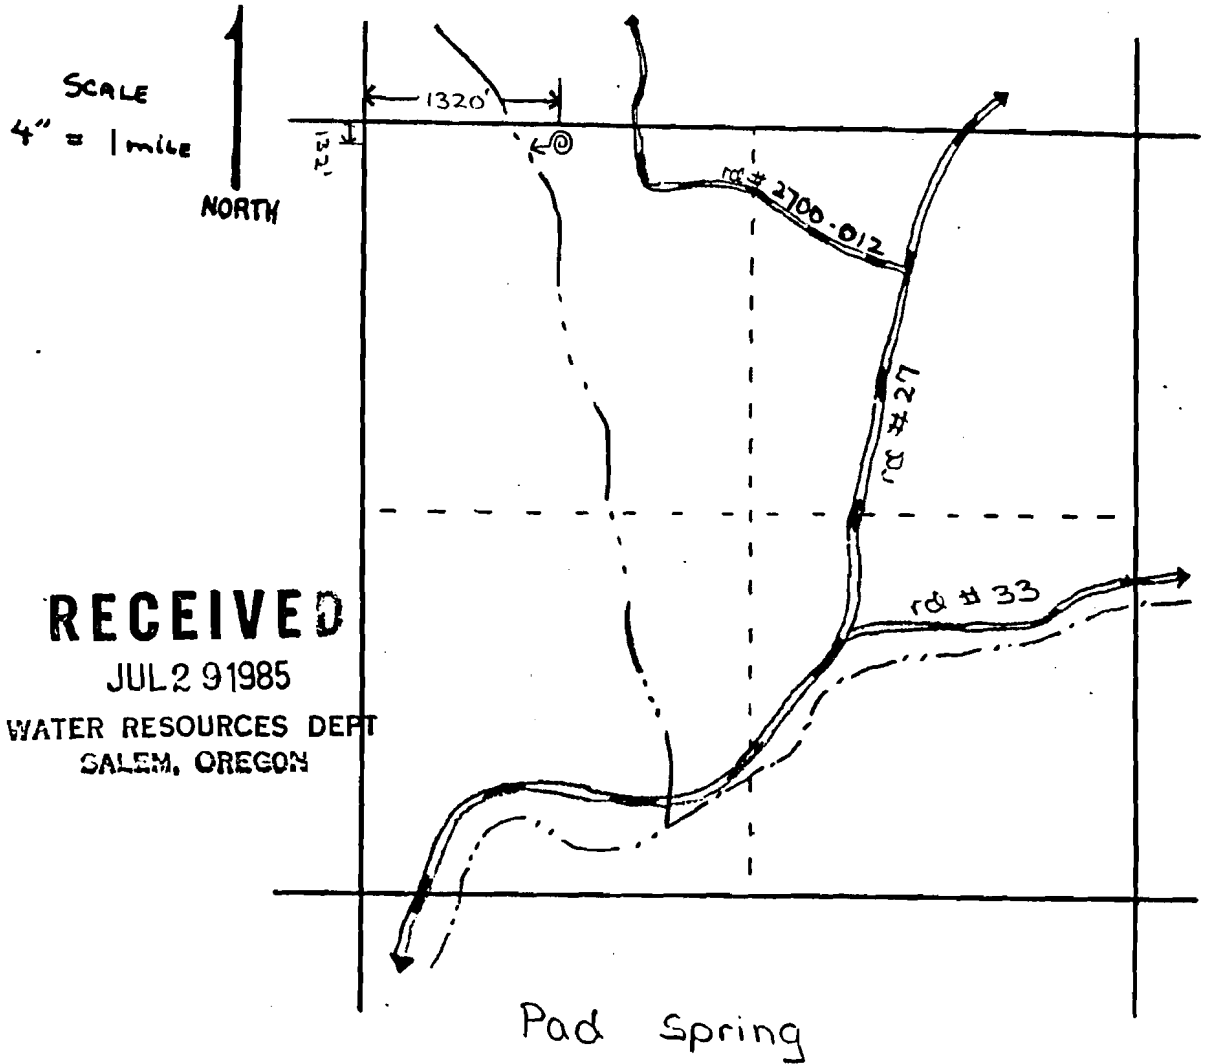

RECEIVED

JUL 29 1985

WATER RESOURCES DEPT
SALEM, OREGON

Application No. 68448
Permit No. 49441

cert. 63974

Scale

1 inch = 40 feet

RECEIVED

DATE 2-28-90

WATER MASTER DISTRICT #11

BY *ms*

Deer Creek
235 feet



49441