


T. 13S. R. 29E. W.M.

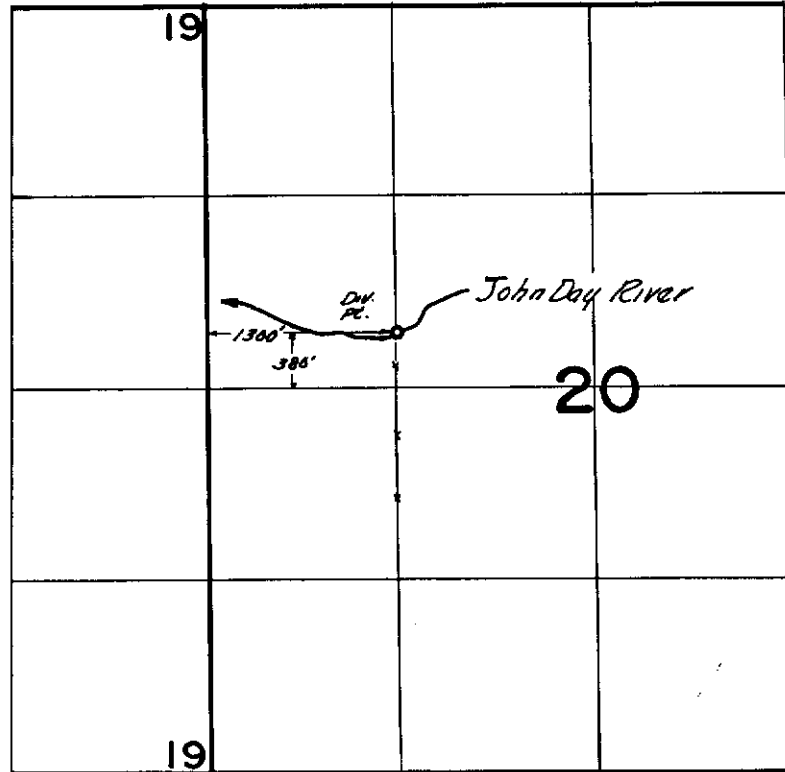

FINAL PROOF SURVEY UNDER

TRANSFER No. 4206
 Application No. Permit No.
 IN NAME OF

..... **GEORGE N. VAN DE HEY**

Surveyed Sept. 19.. 1979., by S.C. BROWN.....


T-4206

RECEIVED

APR 20 1979

T.13S. R. 29E. W.M.

WATER RESOURCES DEPT.
SALEM, OREGON

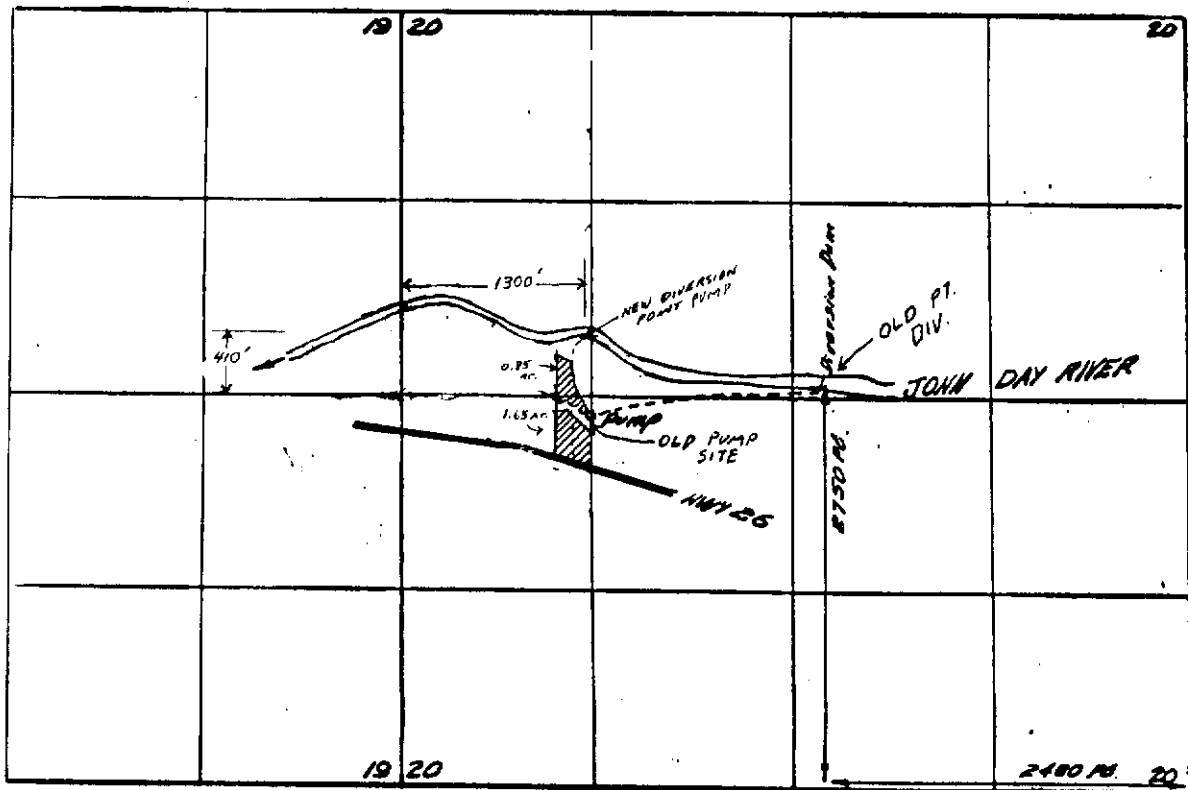

SCALE - 4" = 1 mi.

APPLICATION MAP FOR
GEORGE VAN DE HAY

APPROVED

George Van de Hay

THIS MAP PREPARED BY:

Charles D. Cluff 8-28-78

FROM INFORMATION FURNISHED BY
THE APPLICANT.