


T. 24 S. R. 30 E. W. M.

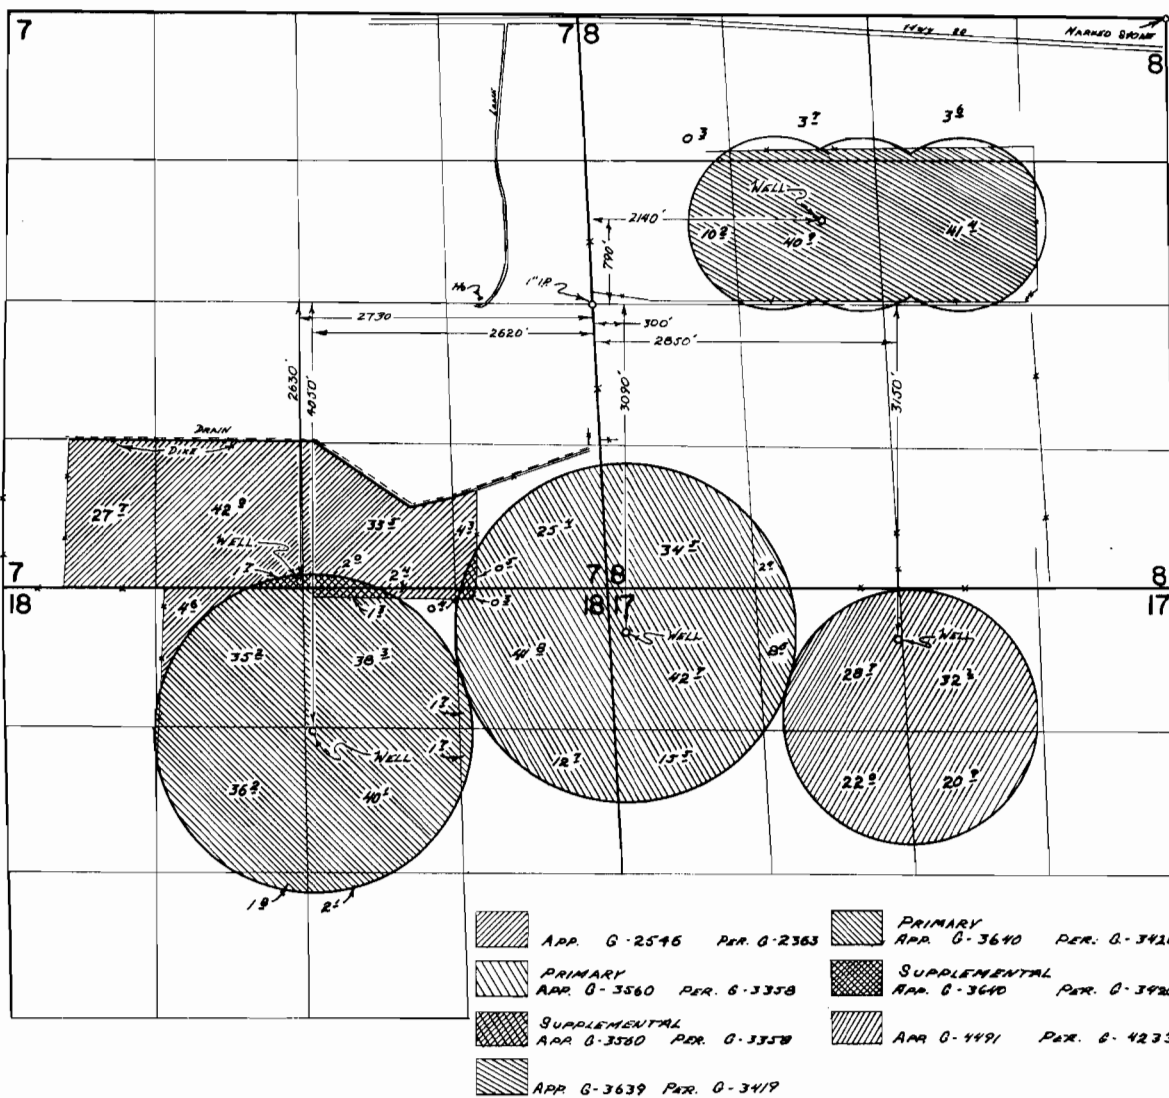

FINAL PROOF SURVEY

Urb. L. 18

G- 2546	G- 2363
G- 3560	G- 3358
G- 3640	G- 3420
G- 4491	G- 4233


ADOLF J. KISLE

Surveyed Aug. 23 1972, by R. E. Mucken

T. 24 S., R. 30 E., W. M.



1" = 1320'

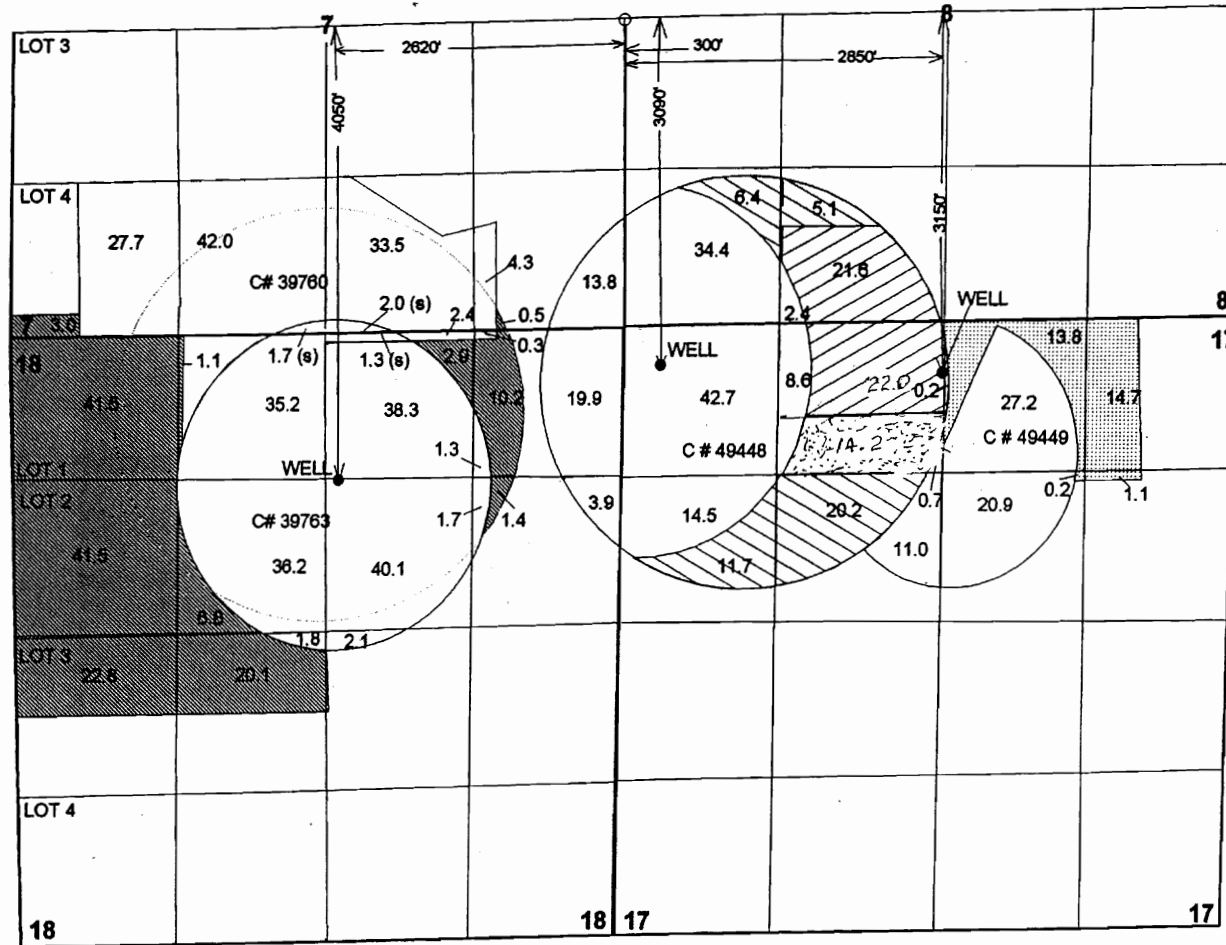

FINAL PROOF SURVEY

UNDER

Transfer No. 4375
Transfer No. 4376

Application No. G-9522 Permit No. G-9382
G-9858 G-9460

IN THE NAME OF

Surveyed 8-8-2001 by J. Miller

- | | |
|--|----------|
| | P # 9382 |
| | P # 9460 |
| | T-4375 |
| | T-4376 |

AMENDED. 4/25/06 LHN
41025-279-133D & LIEKA GPS JM 3-15-2002