


T. 24 S. R. 30 E. W. M.

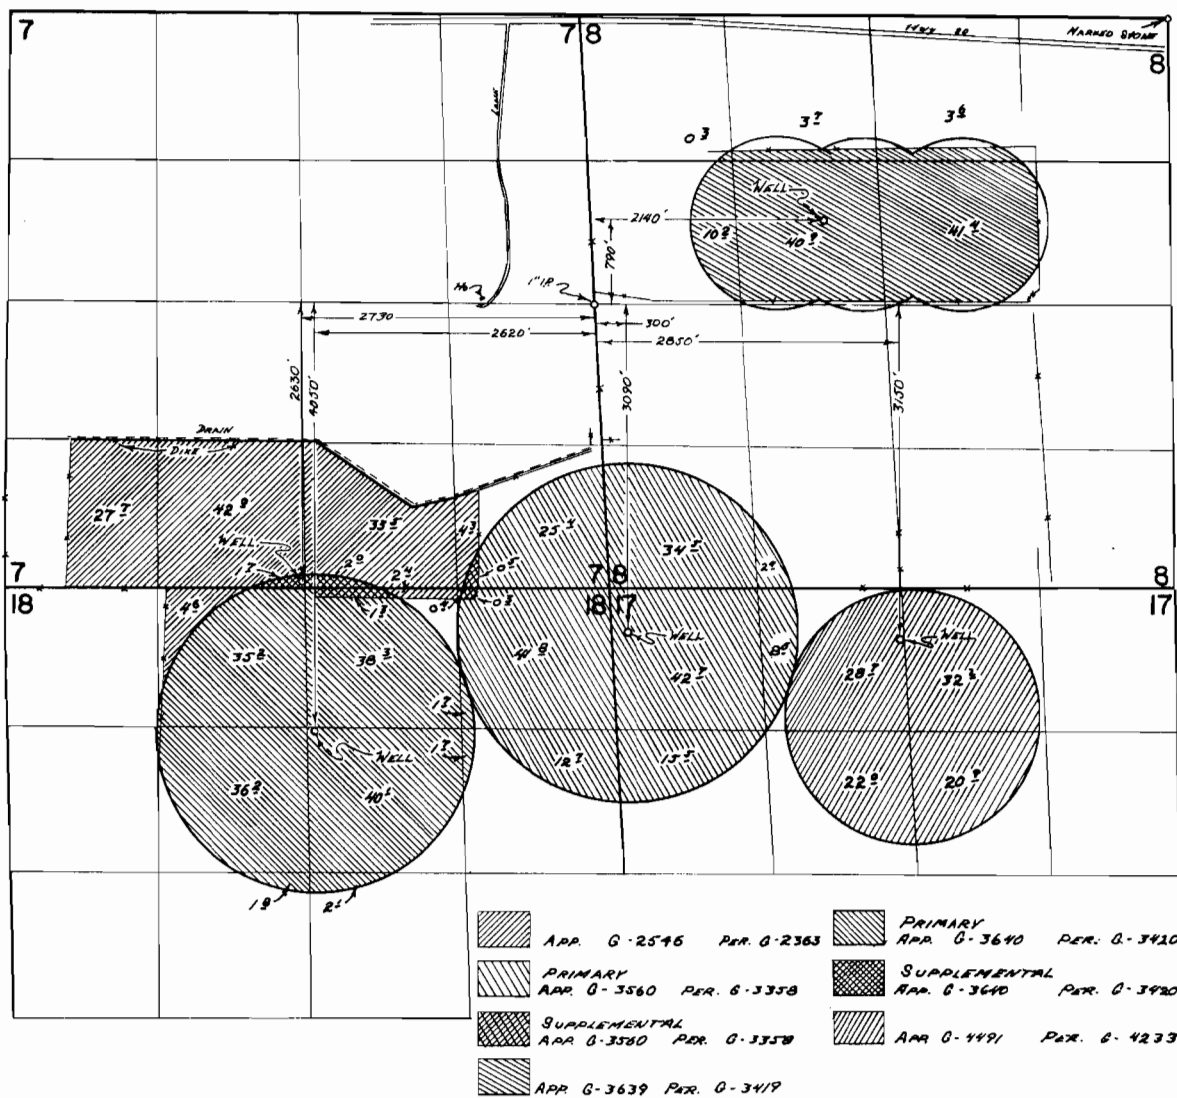

FINAL PROOF SURVEY

Under

Application filed in District No. _____
 G-2546 G-2363
 G-3640 G-3420
 G-4491 G-4233

ADOLF J. KISLE

Surveyed Aug. 23, 1972, by R. E. MUCKEN