


T.40S., R.3E., W.M.

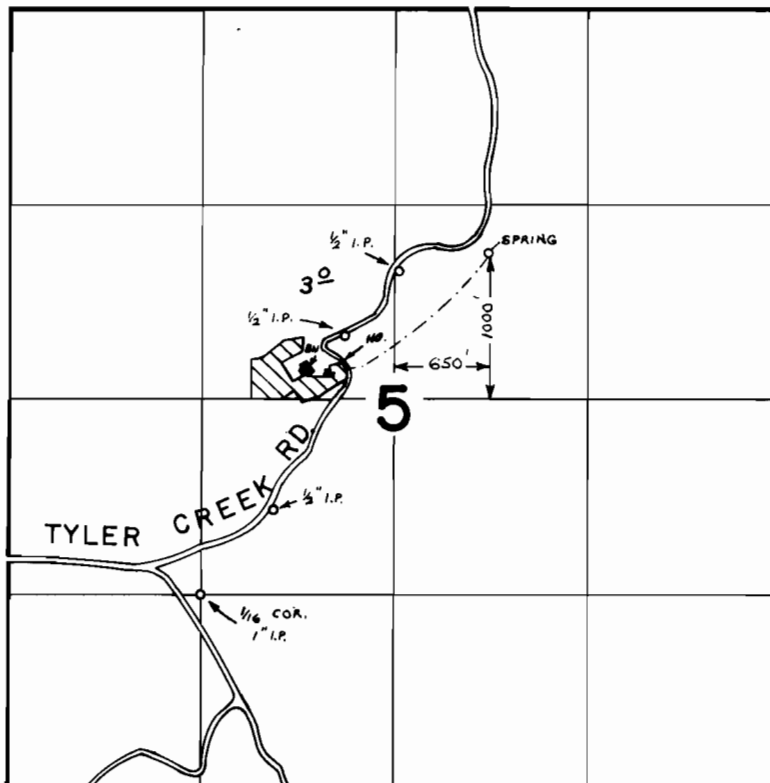

FINAL PROOF SURVEY
UNDER

CERTIFICATE NO. 6070

Application No. Permit No.
IN NAME OF

.....
Surveyed JAN. 16 1980, by B. SUND
JULY 25, 1980

D.H.M.

PHOTO: JAS-69 13-38-16
PTS-1980-14-A