


T. 38 S., R. 4 W., W.M.

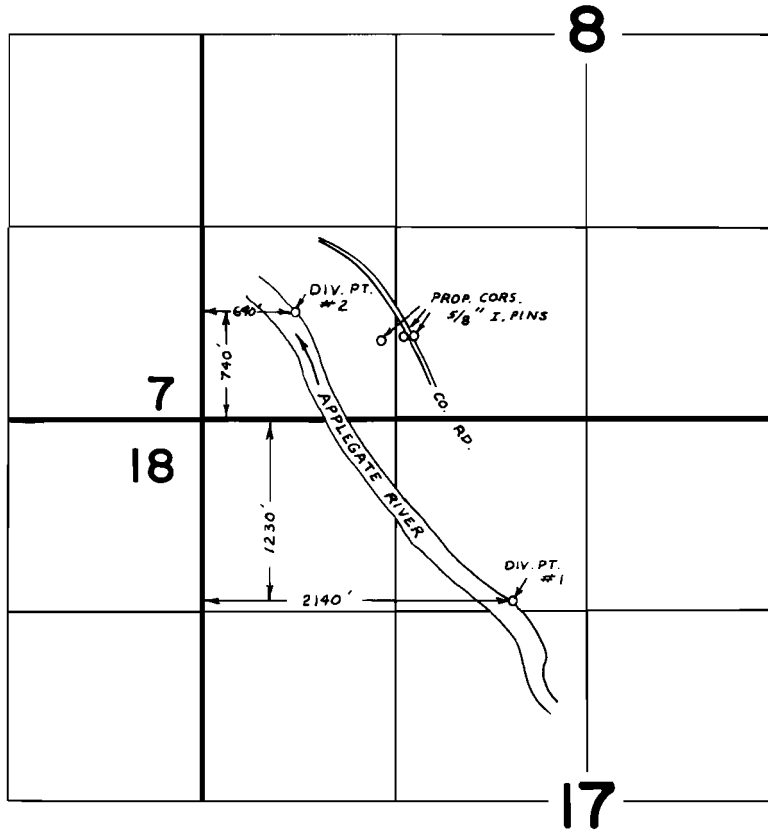

FINAL PROOF SURVEY

UNDER

Transfer No. 3251 DIV. PT. # 1, 2
Transfer No. 3252 DIV. PT. # 1
Transfer No. 3253 DIV. PT. # 1
Application No. Permit No.

IN NAME OF

ZORA M. & CLIFFORD PLANCHON

Surveyed APR. 2 19 79, by B. SUND