


T.14S.R.IW.W.M.

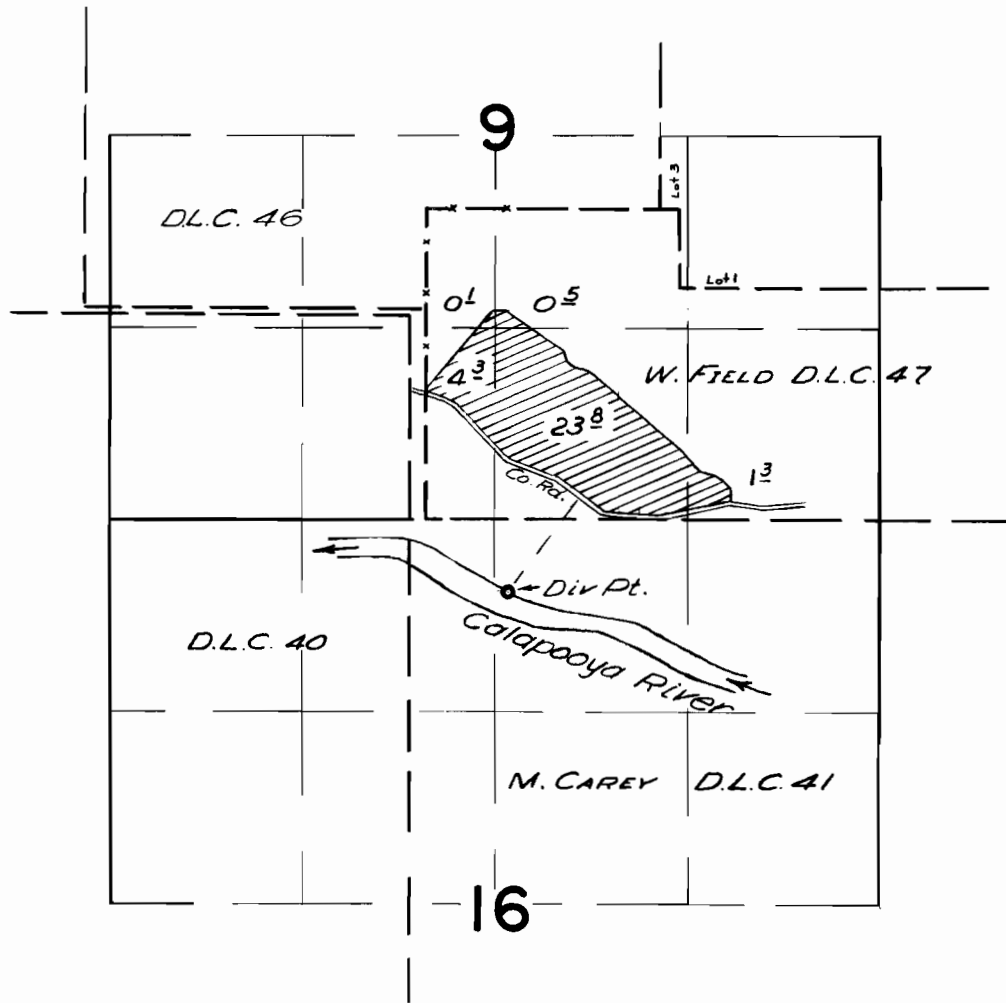

**FINAL PROOF SURVEY**  
UNDER

Application No. 28857 Permit No. 22748  
IN NAME OF

WALTER S. GATES

Surveyed 5 AUG. 1960 by T. B. Bish