


T.18 & 19 S. R. 37 E. W.M.

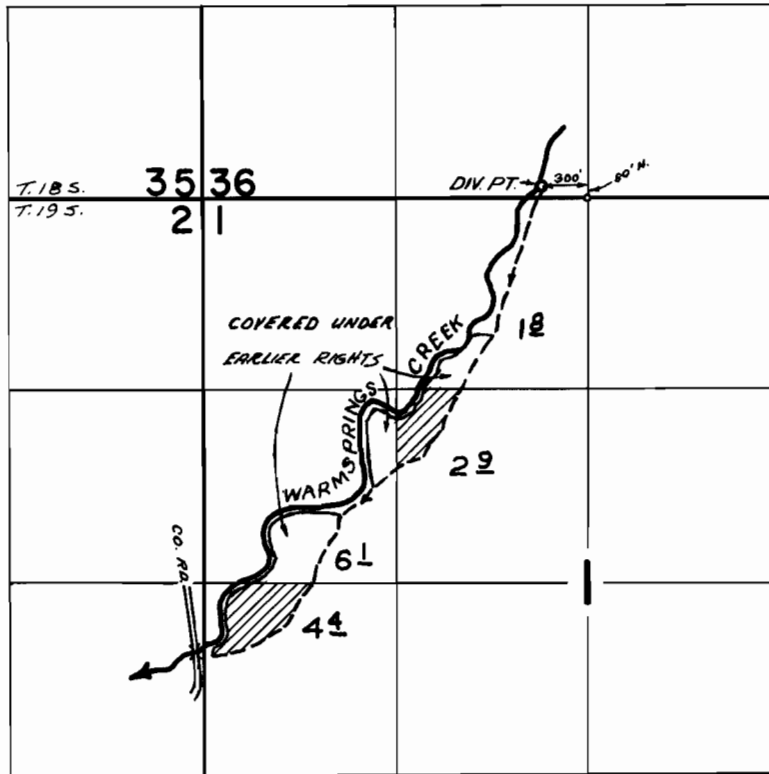

FINAL PROOF SURVEY UNDER

Transfer M-139

Application No. _____ Permit No. _____
IN NAME OF

William Butler

Surveyed Oct 5 1965, by C. GARDNER