


T.6&7S. R.IW. W.M.

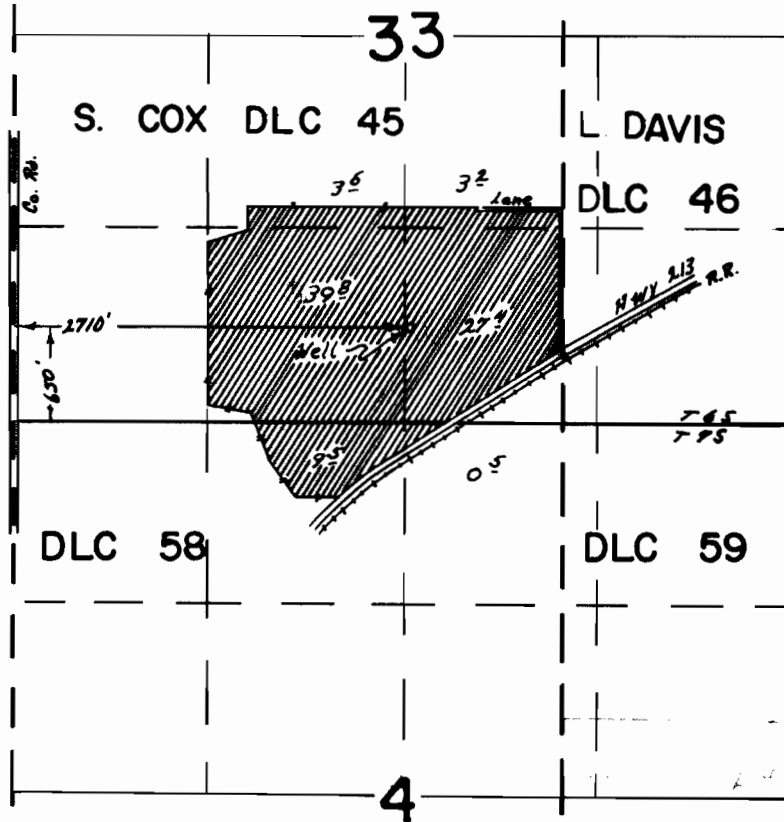

FINAL PROOF SURVEY
UNDER

Application No. B-4853 Permit No. B-4569
IN NAME OF

MARTIN WERNER MAURER

Surveyed May 31 1972, by R. B. Mucken