


T.9S.R.5W.W.M.

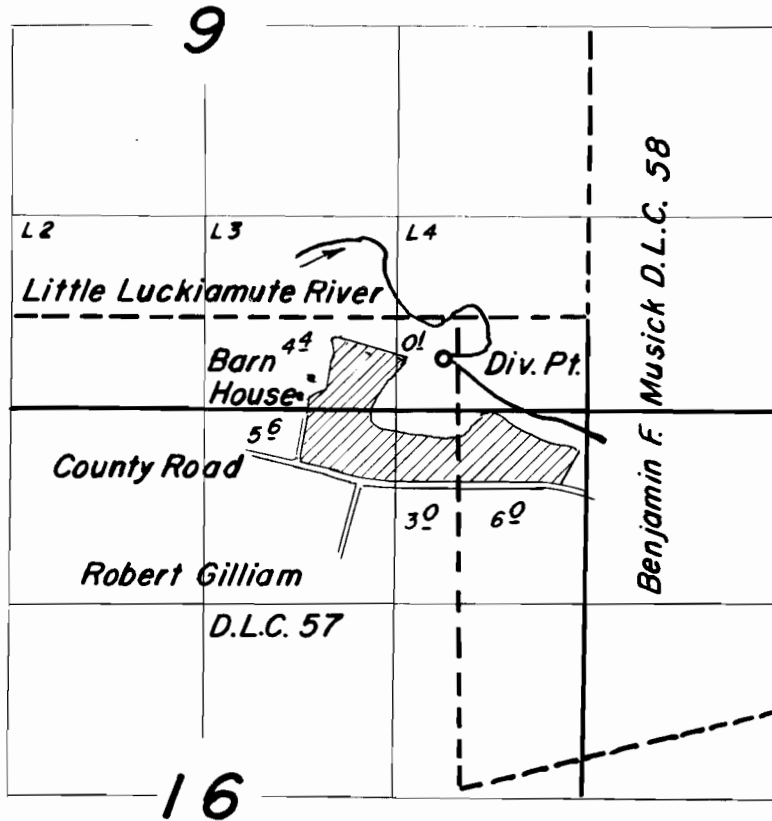

FINAL PROOF SURVEY
UNDER

Application No. 34470 Permit No. 27073
IN NAME OF

Jesse Payne

Surveyed May 24 1963, by Floyd L. Siegmund