

T. 6 N. R. 35 E. WM


FINAL PROOF SURVEY
UNDER

Name	Appl. No.	Permit No.
J. B. Heitstuman	U-351	U-345
Mrs. W. W. Ward	U-388	U-358
W. W. Ward	U-296	U-271
C. Burggraff	U-490	U-442
C. Burggraff	U-443	U-398
R. P. Lile	25568	20072

Surveyed May 14-15, 1954
by
H. L. Coffman

NZ-5F-106

T. 6 N., R 35 E

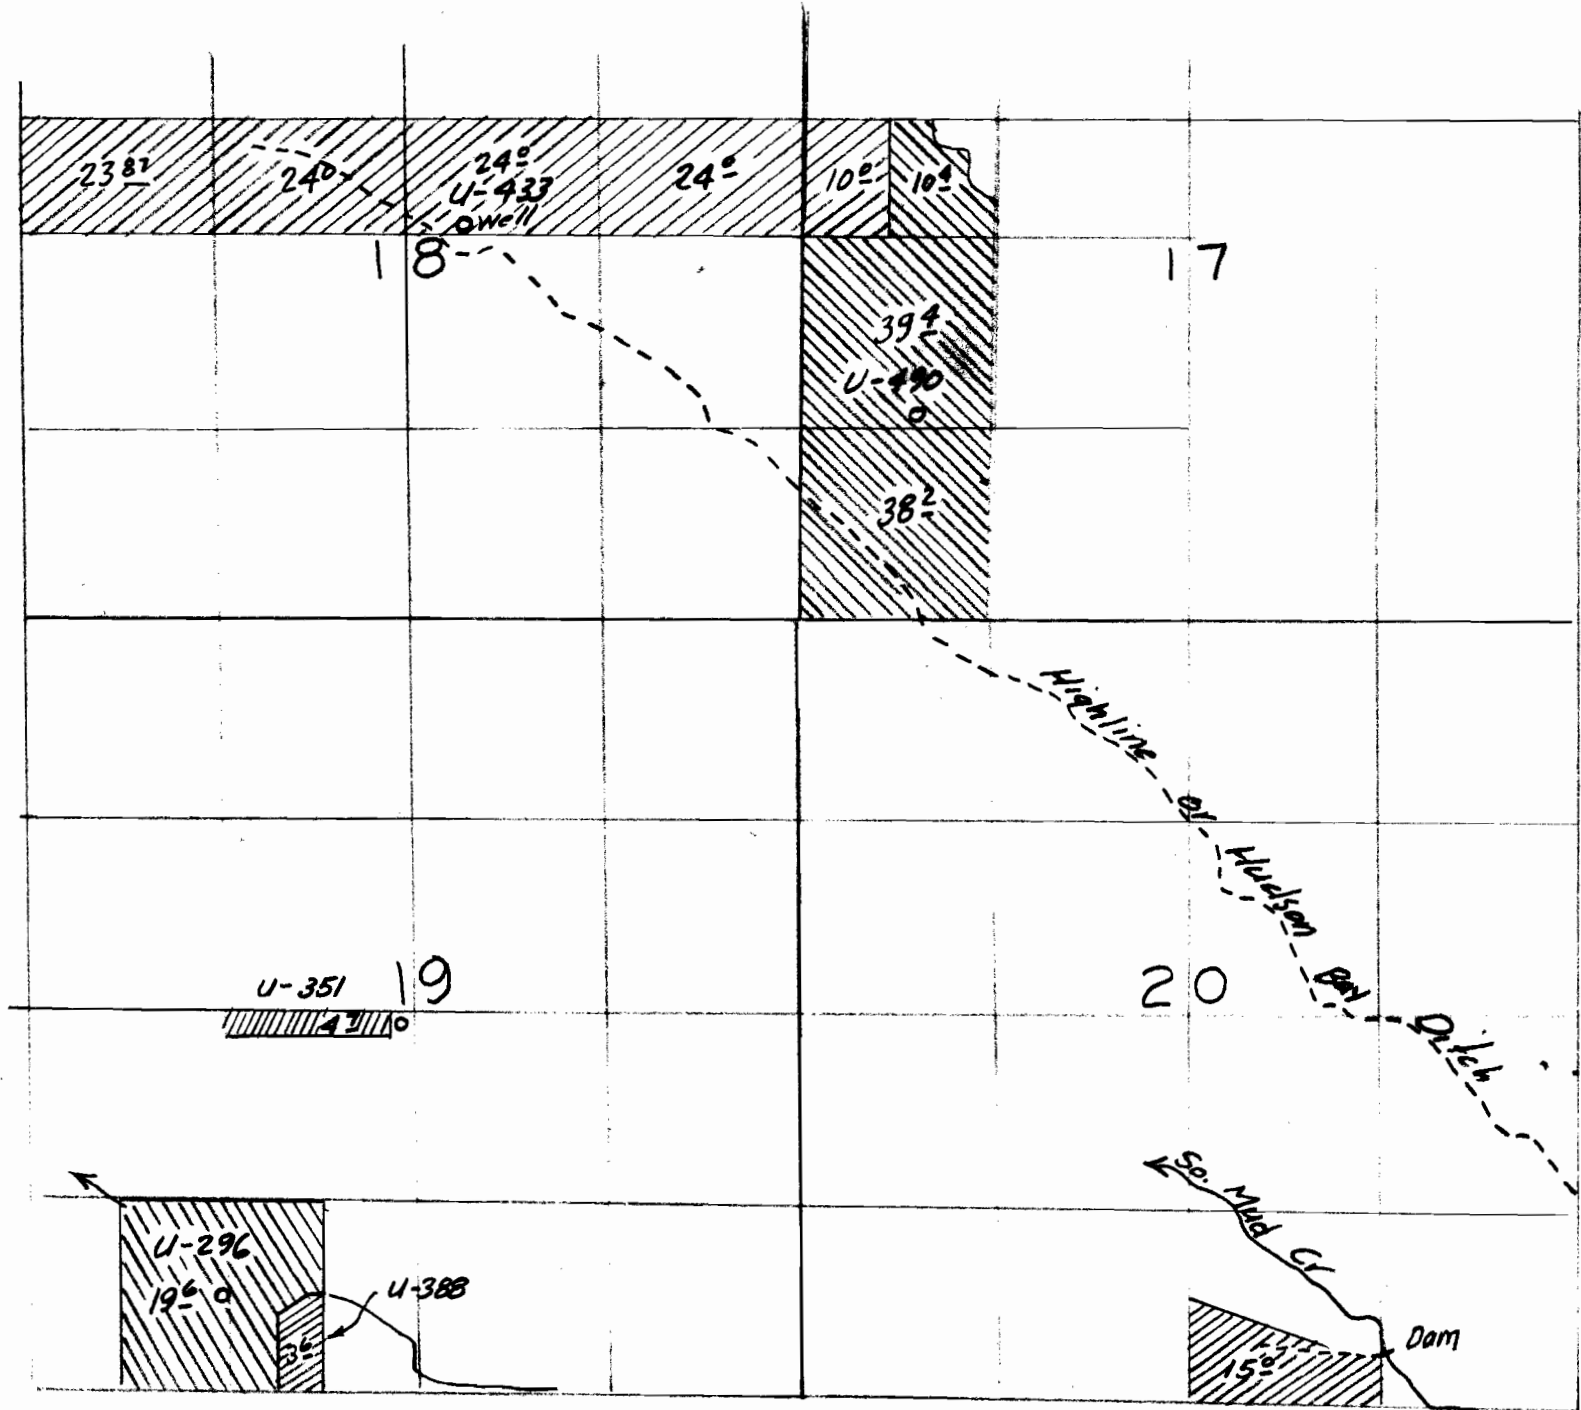

Copied from final proof photo app 25568
Per 20072