


T. 1N. R. 13E. W.M.

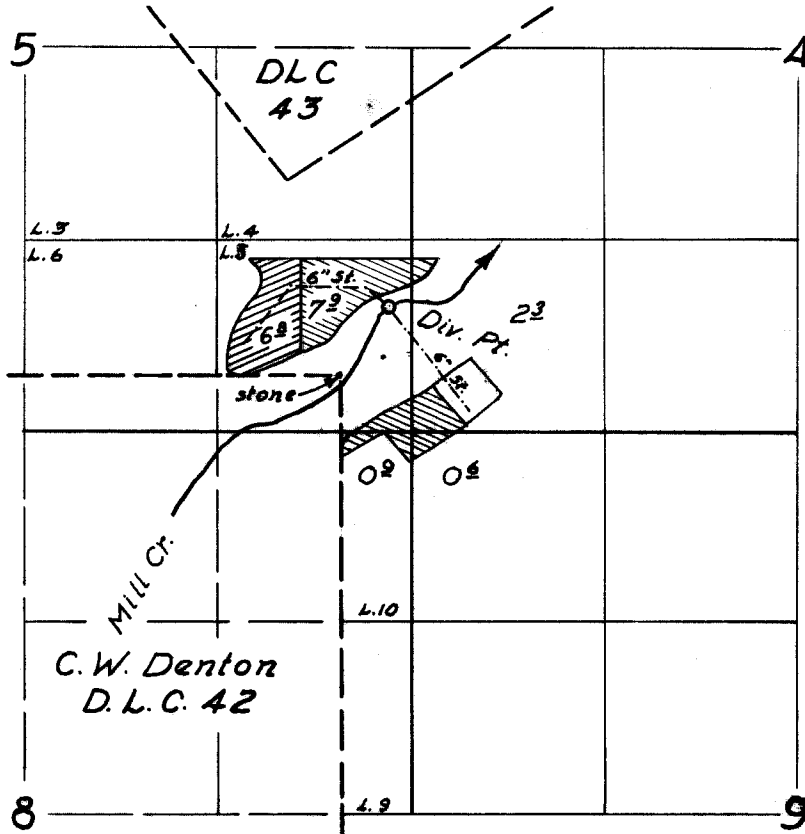

**FINAL PROOF SURVEY**  
UNDER

Transfer No. E-35   
Application No. 34577 Permit No. 27155   
IN NAME OF

Walter Erickson

Surveyed May 14 1962, by L.W. Dehoussek