


T.1&2S.,R.13E.,W.M.

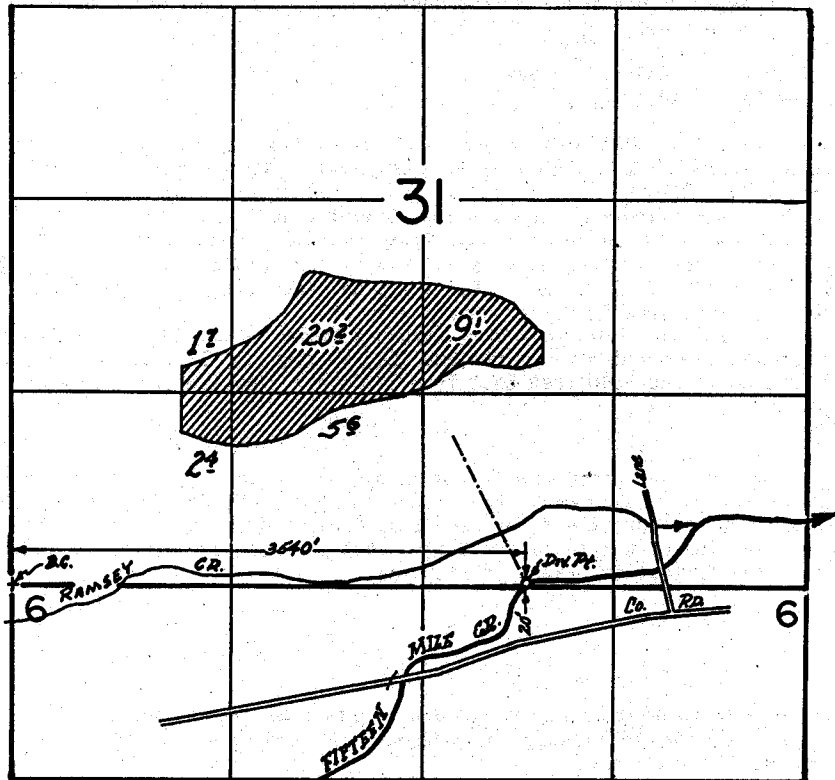

FINAL PROOF SURVEY UNDER

Transfer No. 3400

Application No. Permit No.

IN NAME OF

RICK CANTRELL

Surveyed April 28 1978, by A. Depligate