


T. 1 N., R. 1 W., W.M.

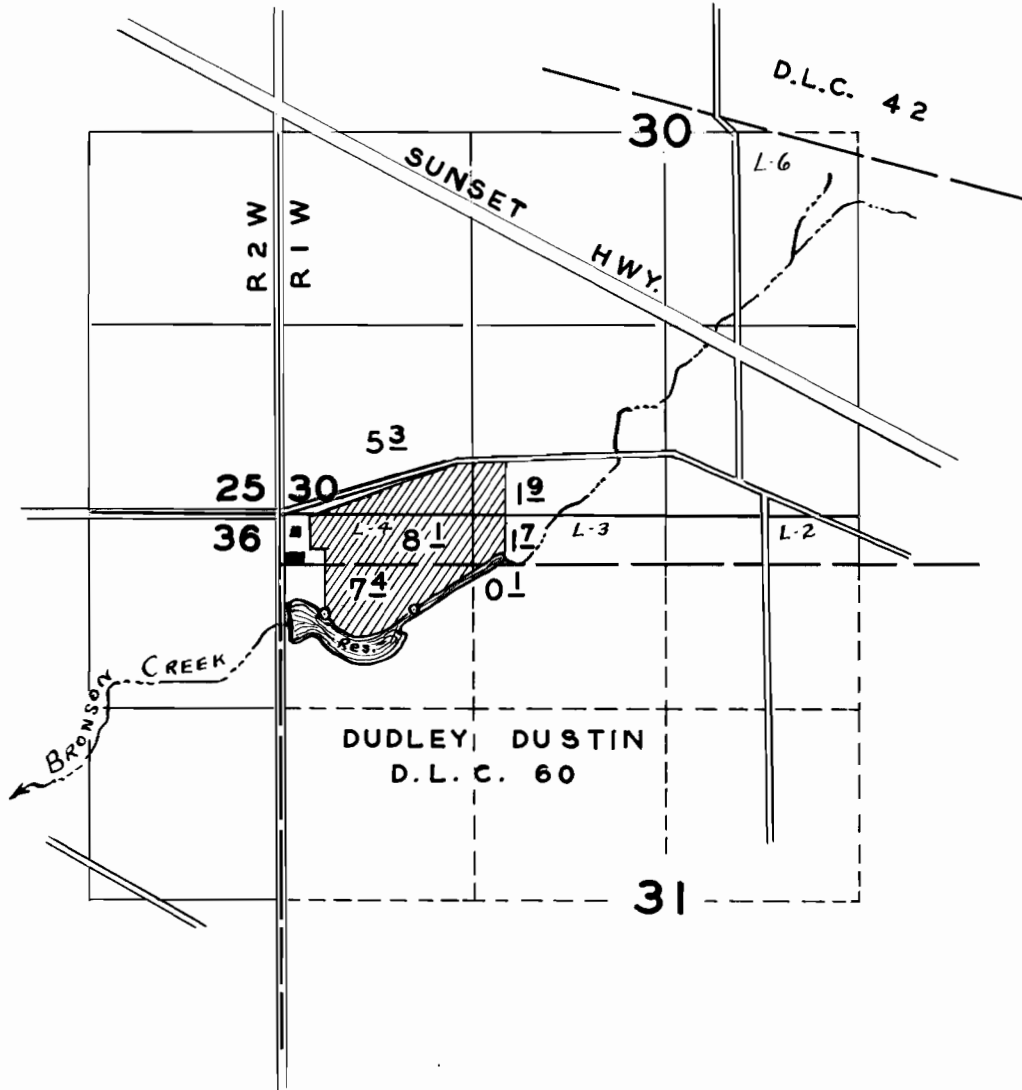

FINAL PROOF SURVEY

UNDER

R-29791 R-1699

Application No. 29792 Permit No. 23318

IN NAME OF

MARK P. MILLER

Surveyed 4 - 9 1956, by M. BISH