


T. 33 S., R. 5 W., W.M.

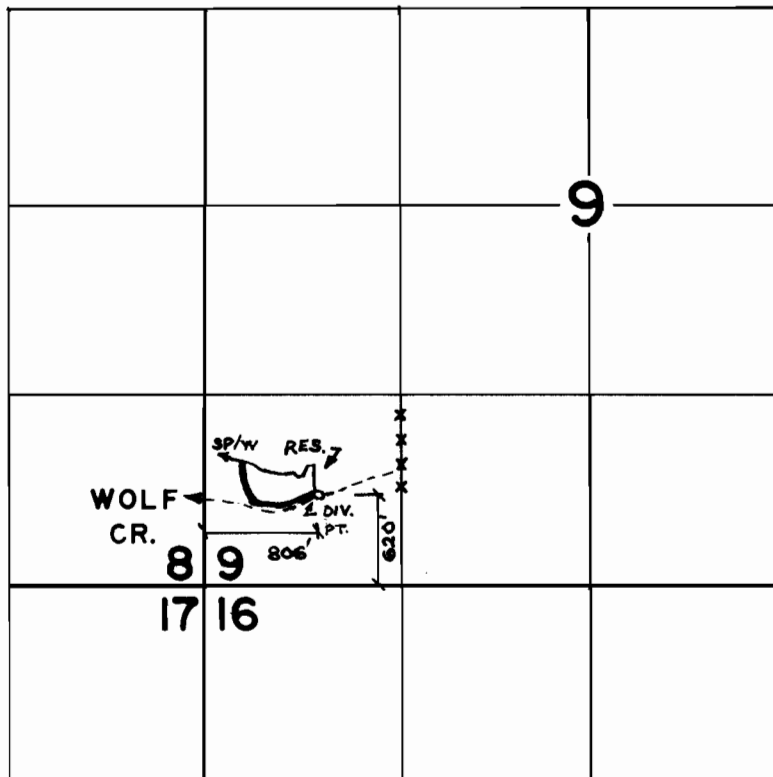

FINAL PROOF SURVEY
UNDER

R-47828 R-5795
Application No. 47908 Permit No. 35898
IN NAME OF

OVE S. R. BECK

Surveyed OCT. 26 1977, by B. SUND