


TOWNSHIP 7 SOUTH RANGE 39 EAST W.M.

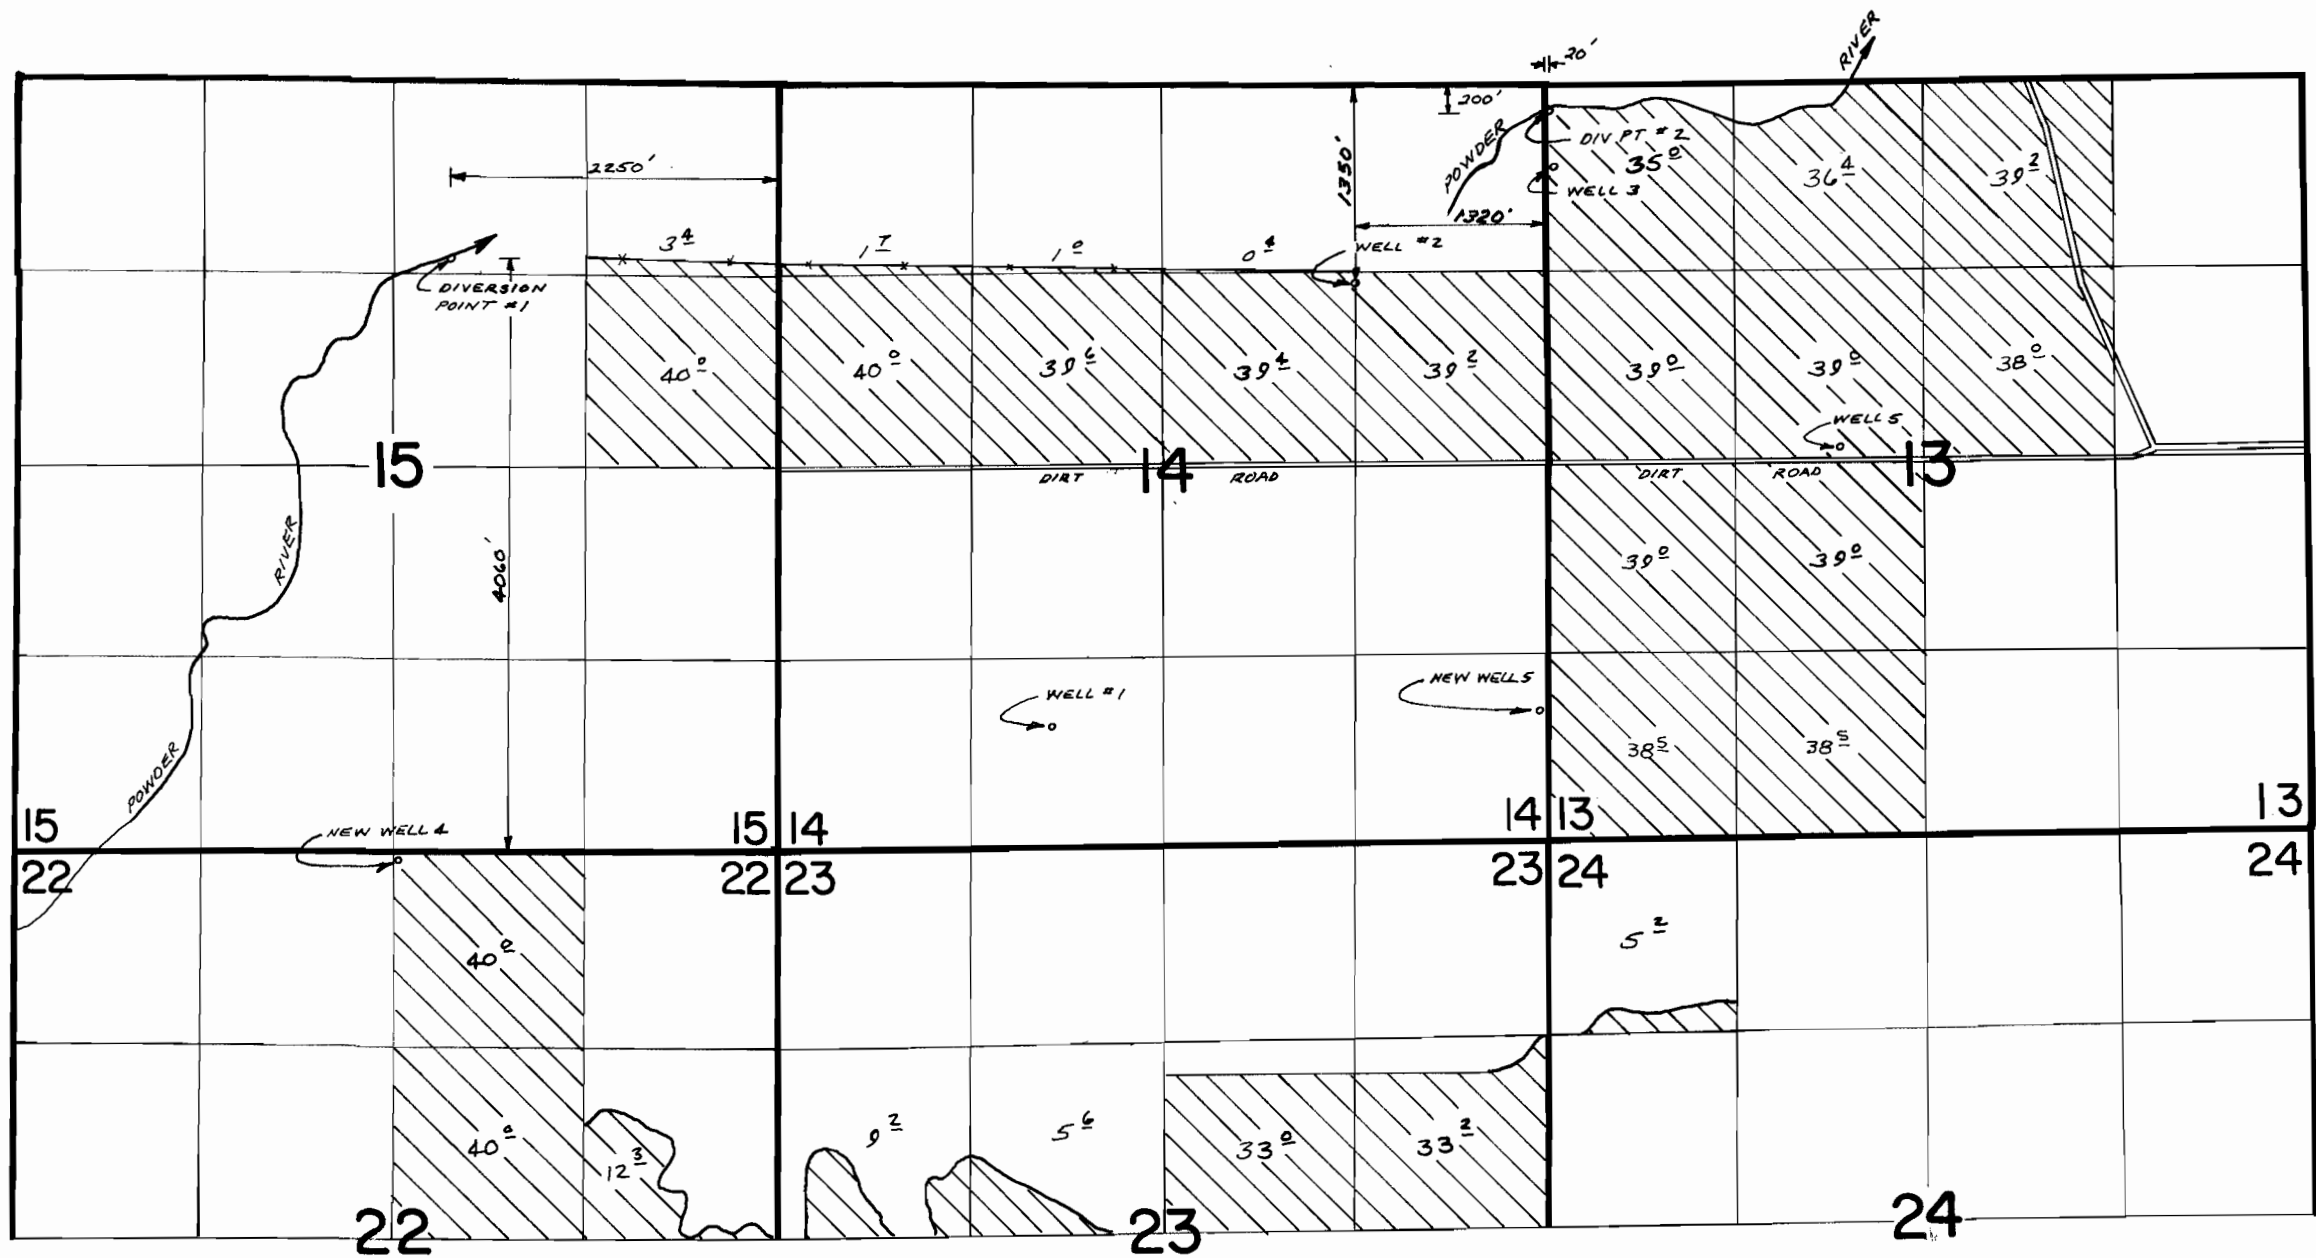

FINAL PROOF SURVEY

UNDER

G-6743 G-6011  
APPLICATION NO 52611 PERMIT 38638

IN NAME OF

BURR COURTRIGHT

SURVEYED OCT 25, 1977 BY R. BARWIN

BBB-4KK-258  
BBB-4KK-171