



Superseded

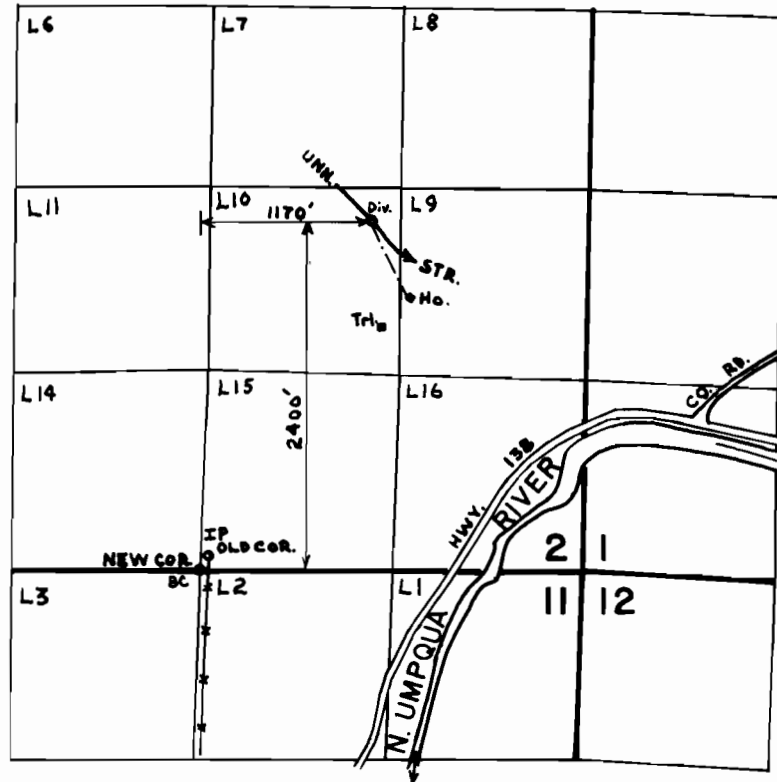

Application No. 50210 Permit No. 37700
IN NAME OF

Surveyed JUNE 29 1978, by D.W. SPARKS....

T.26S. R.3W. W.M.

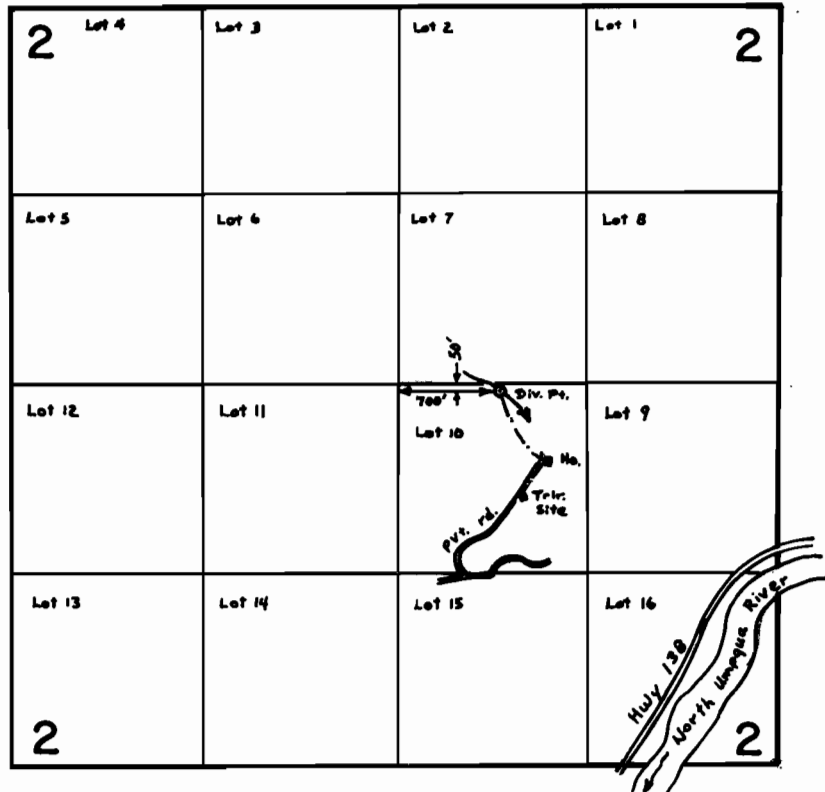

SCALE: 4" = 1 mile

FINAL PROOF SURVEY
UNDER

Application No. 50210 Permit No. 37700
IN NAME OF

LAWRENCE A. COLLINS, Jr.

Surveyed June 29 1978, by D. Sparks
Jan. 22 1980, by S. Donaldson