


T.29S. R.14W. W.M.

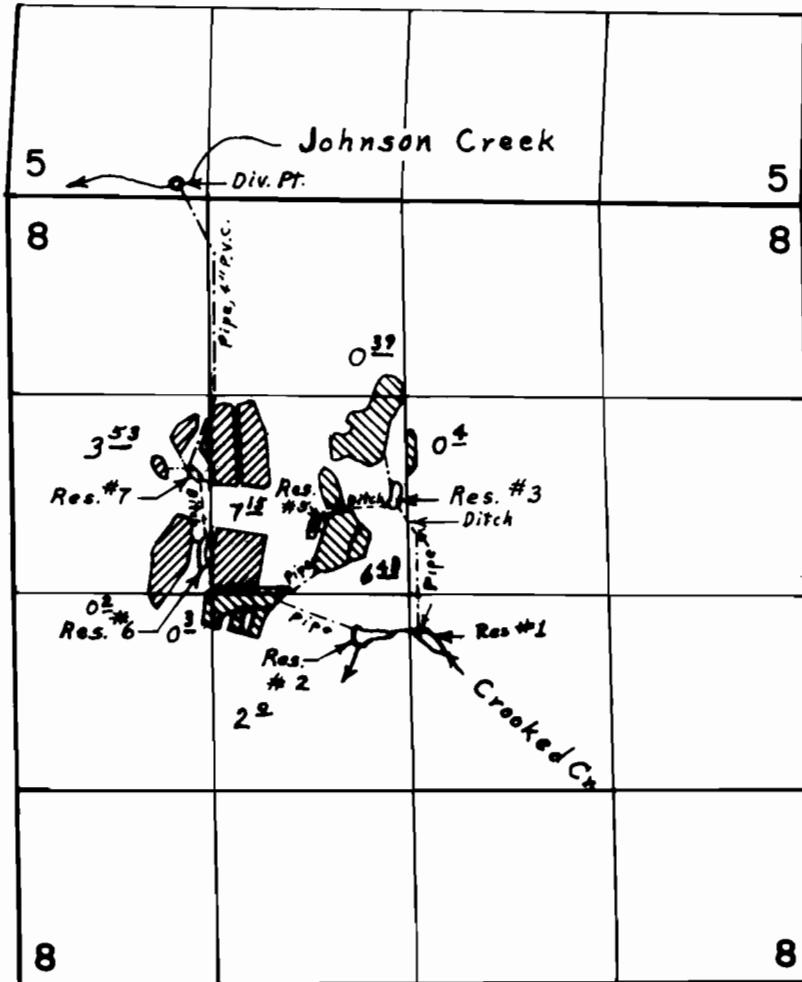

Crooked Creek- Res. 1- 250' S & 40' E, Res. 2- 350' S & 370' W,
 Res. 3- 650' N & 110' W, Res. 5- 440' N & 670' W; Johnson Creek-
 2820' N & 1570' W, Res. 6- 280' N & 1430' W, Res. 7- 830' N & 1480' W all from
 the C 1/4 cor Section 8

Johnson Cr. & Res.
 Crooked Cr & Res.

FINAL PROOF SURVEY UNDER

R-45808 R-5461
 Application No. 45801 Permit No. 34284
 IN NAME OF

G. FRED & BARBARA J. COX

Surveyed July 21, 1976, by L. E. Gould.